



KEY PLAN: ATRIUM

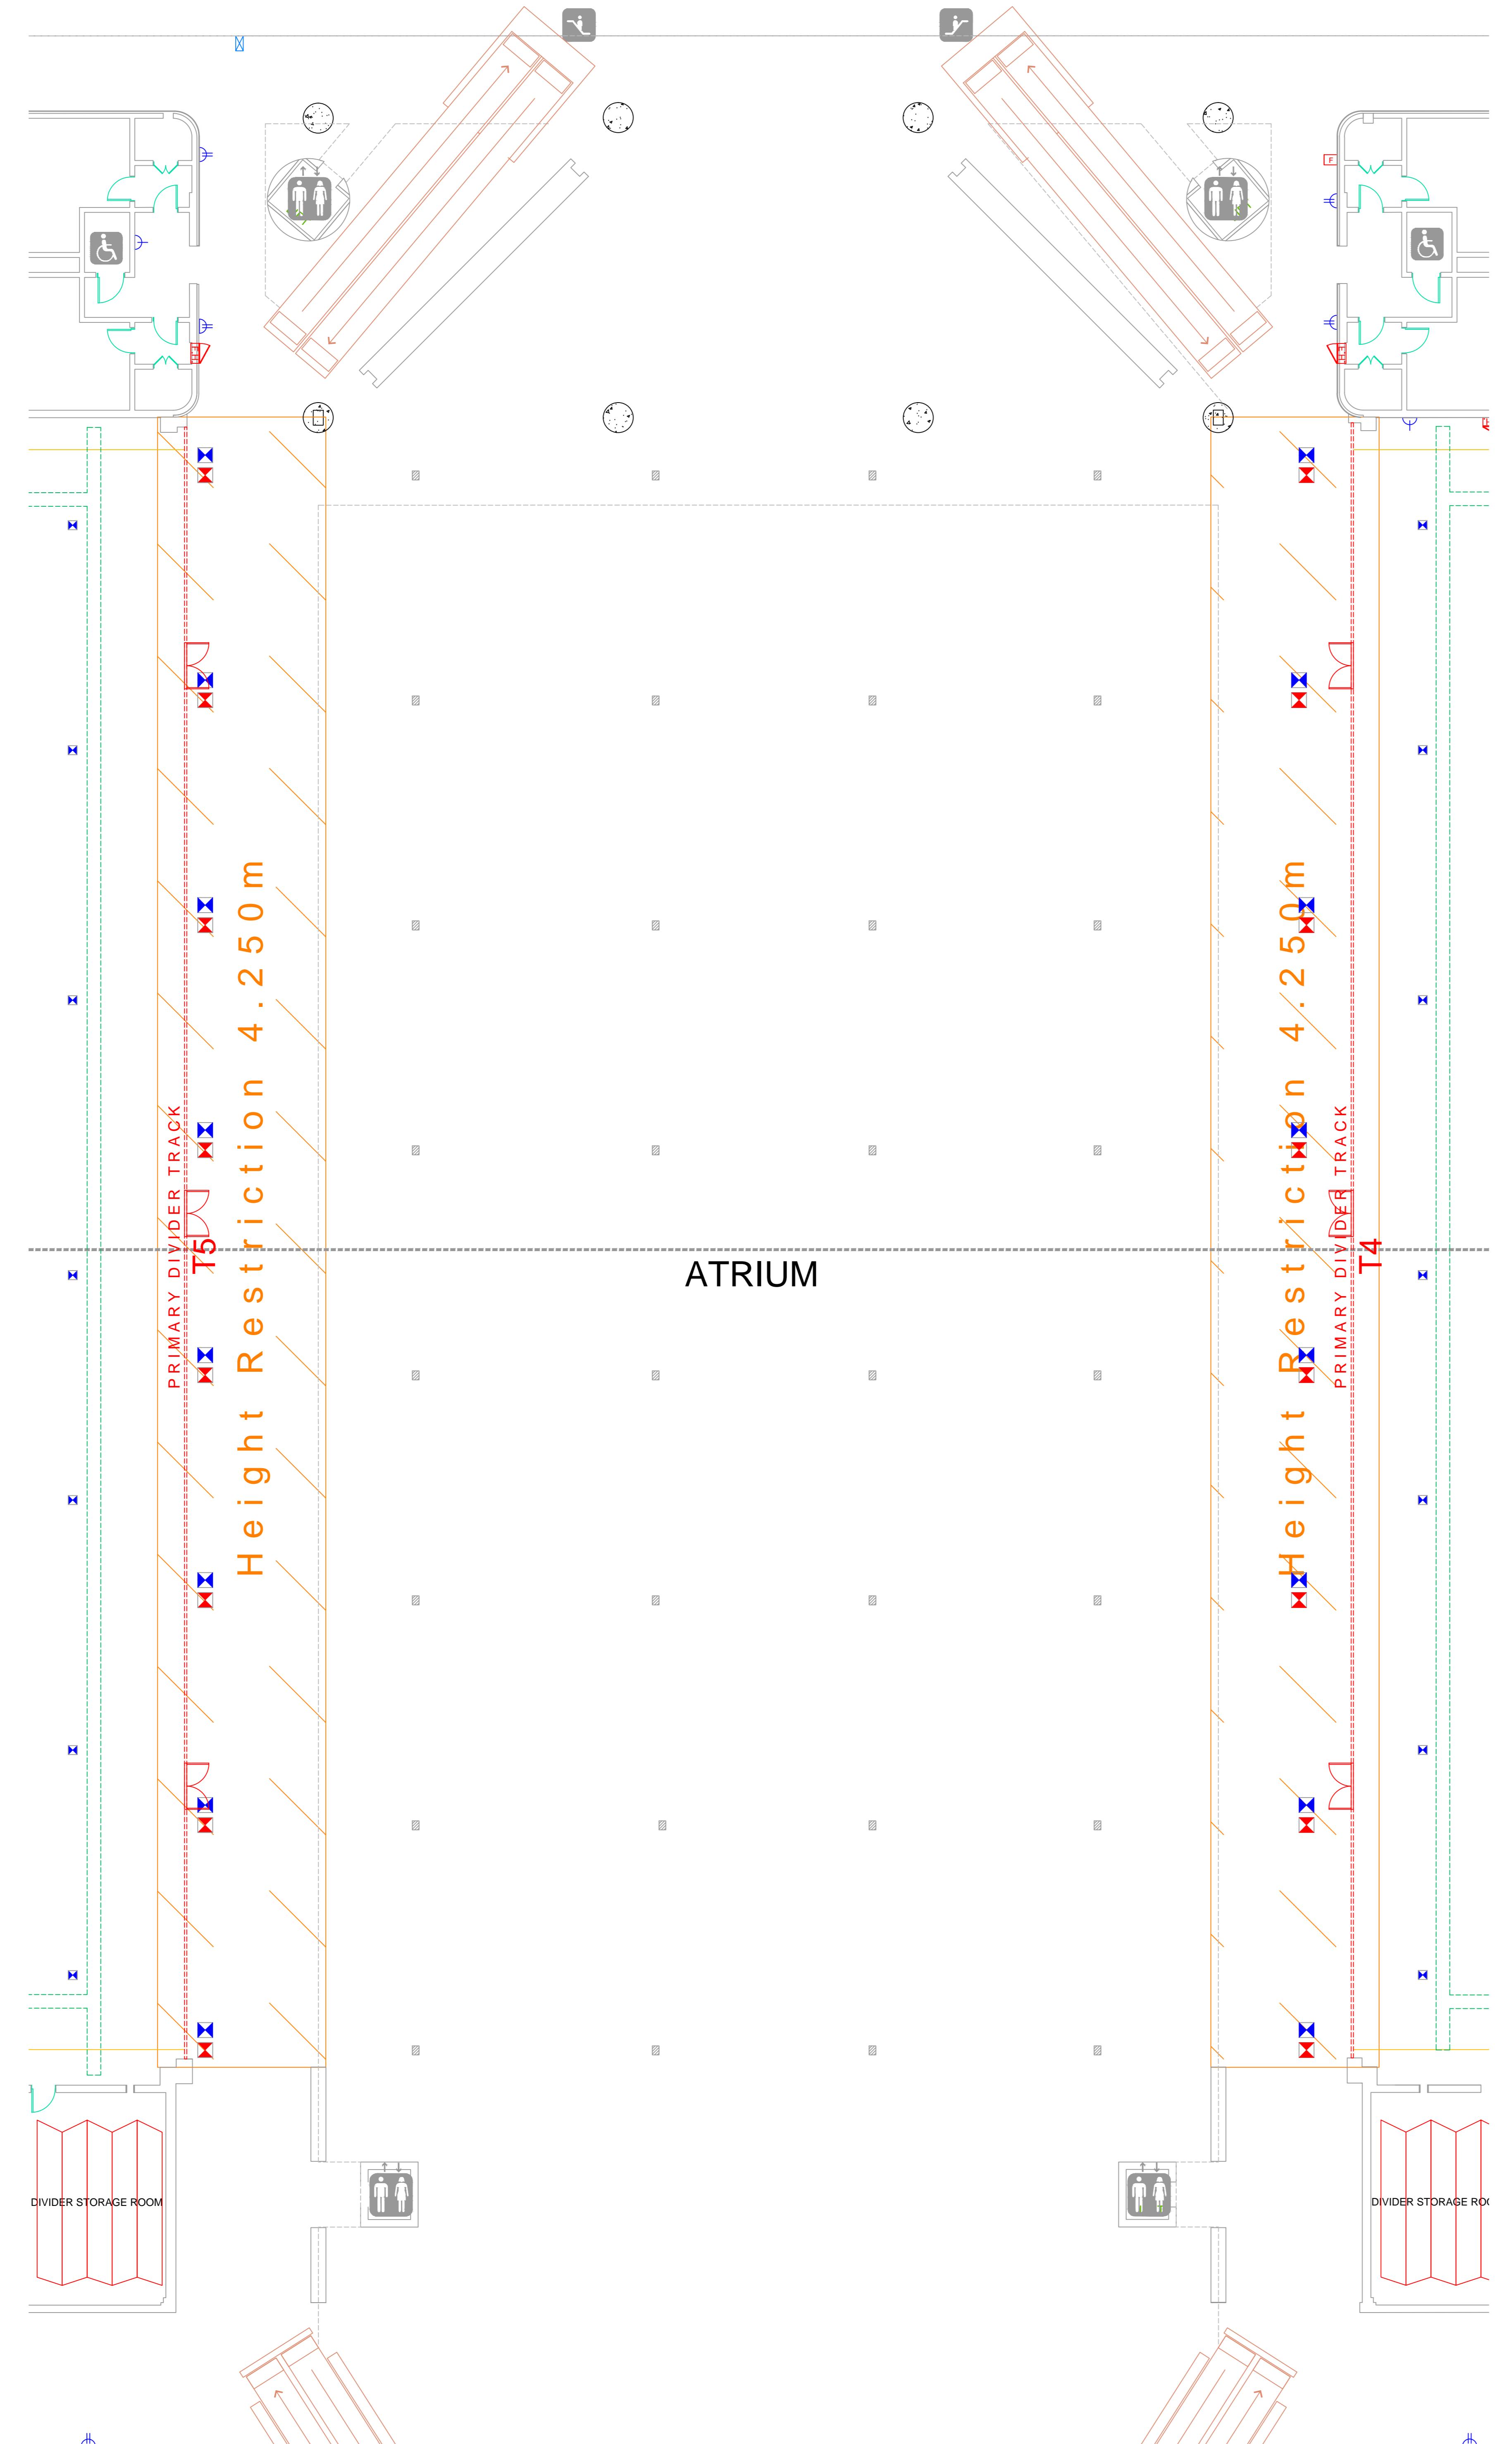


REV. #	REVISION	DATE	REVISED BY
1	AS PER SITE SURVEY	4/25/2011	Chris
2	ALOFT ENTRANCE AMENDED, H1 FLOOR TRENCH & CENTRE PLAZA PARKING	05/01/2011	Chris

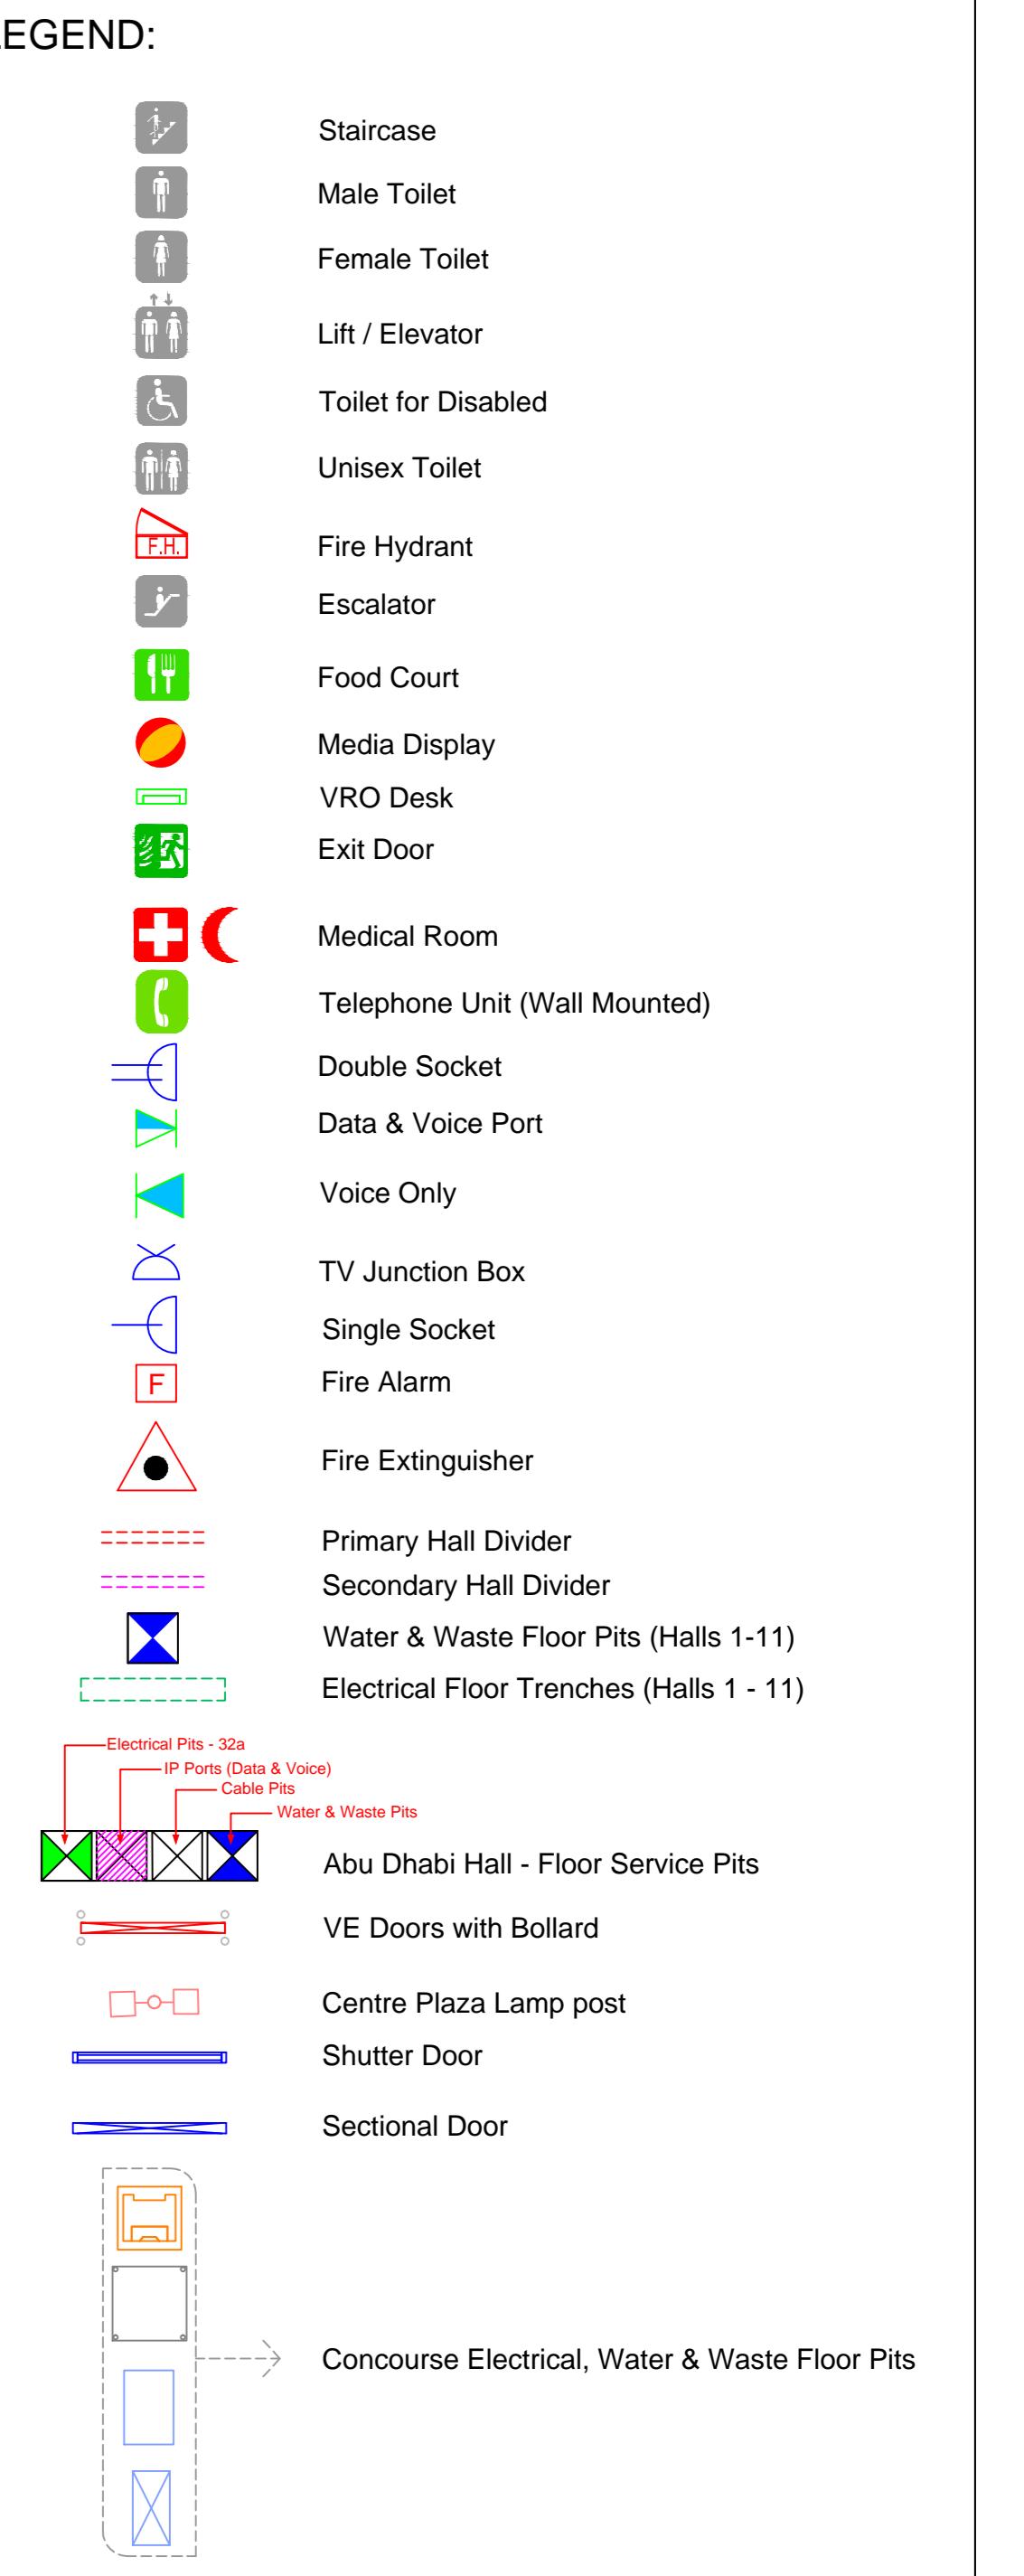



© COPYRIGHT NOTICE
 This drawing is provided in electronic format (.dwg file) for "information purposes" only without any liability on the part of ADNEC. The file, and its contents, remain the property of ADNEC, and shall not be reproduced or re-issued to any third party without express written authorisation from ADNEC.
 The drawing is for reference only and may be subject to change without notice. Updates to this drawing may occur at undefined intervals and shall be notified at the sole discretion of ADNEC. Users are responsible for ensuring that critical dimensions and features are independently verified prior to commencement of any works.

DRAWING TITLE: ADNEC
AS BUILT - GROUND FLOOR
GENERAL ARRANGEMENT


SCALE:	1:125 @ A0	DRAWING NO.	ADNEC-VGF01-GA
DATE:	16-01-12		
APPROVED BY:	Adrian Finn		
DRAWN BY:	Chris Lopez		

 

 


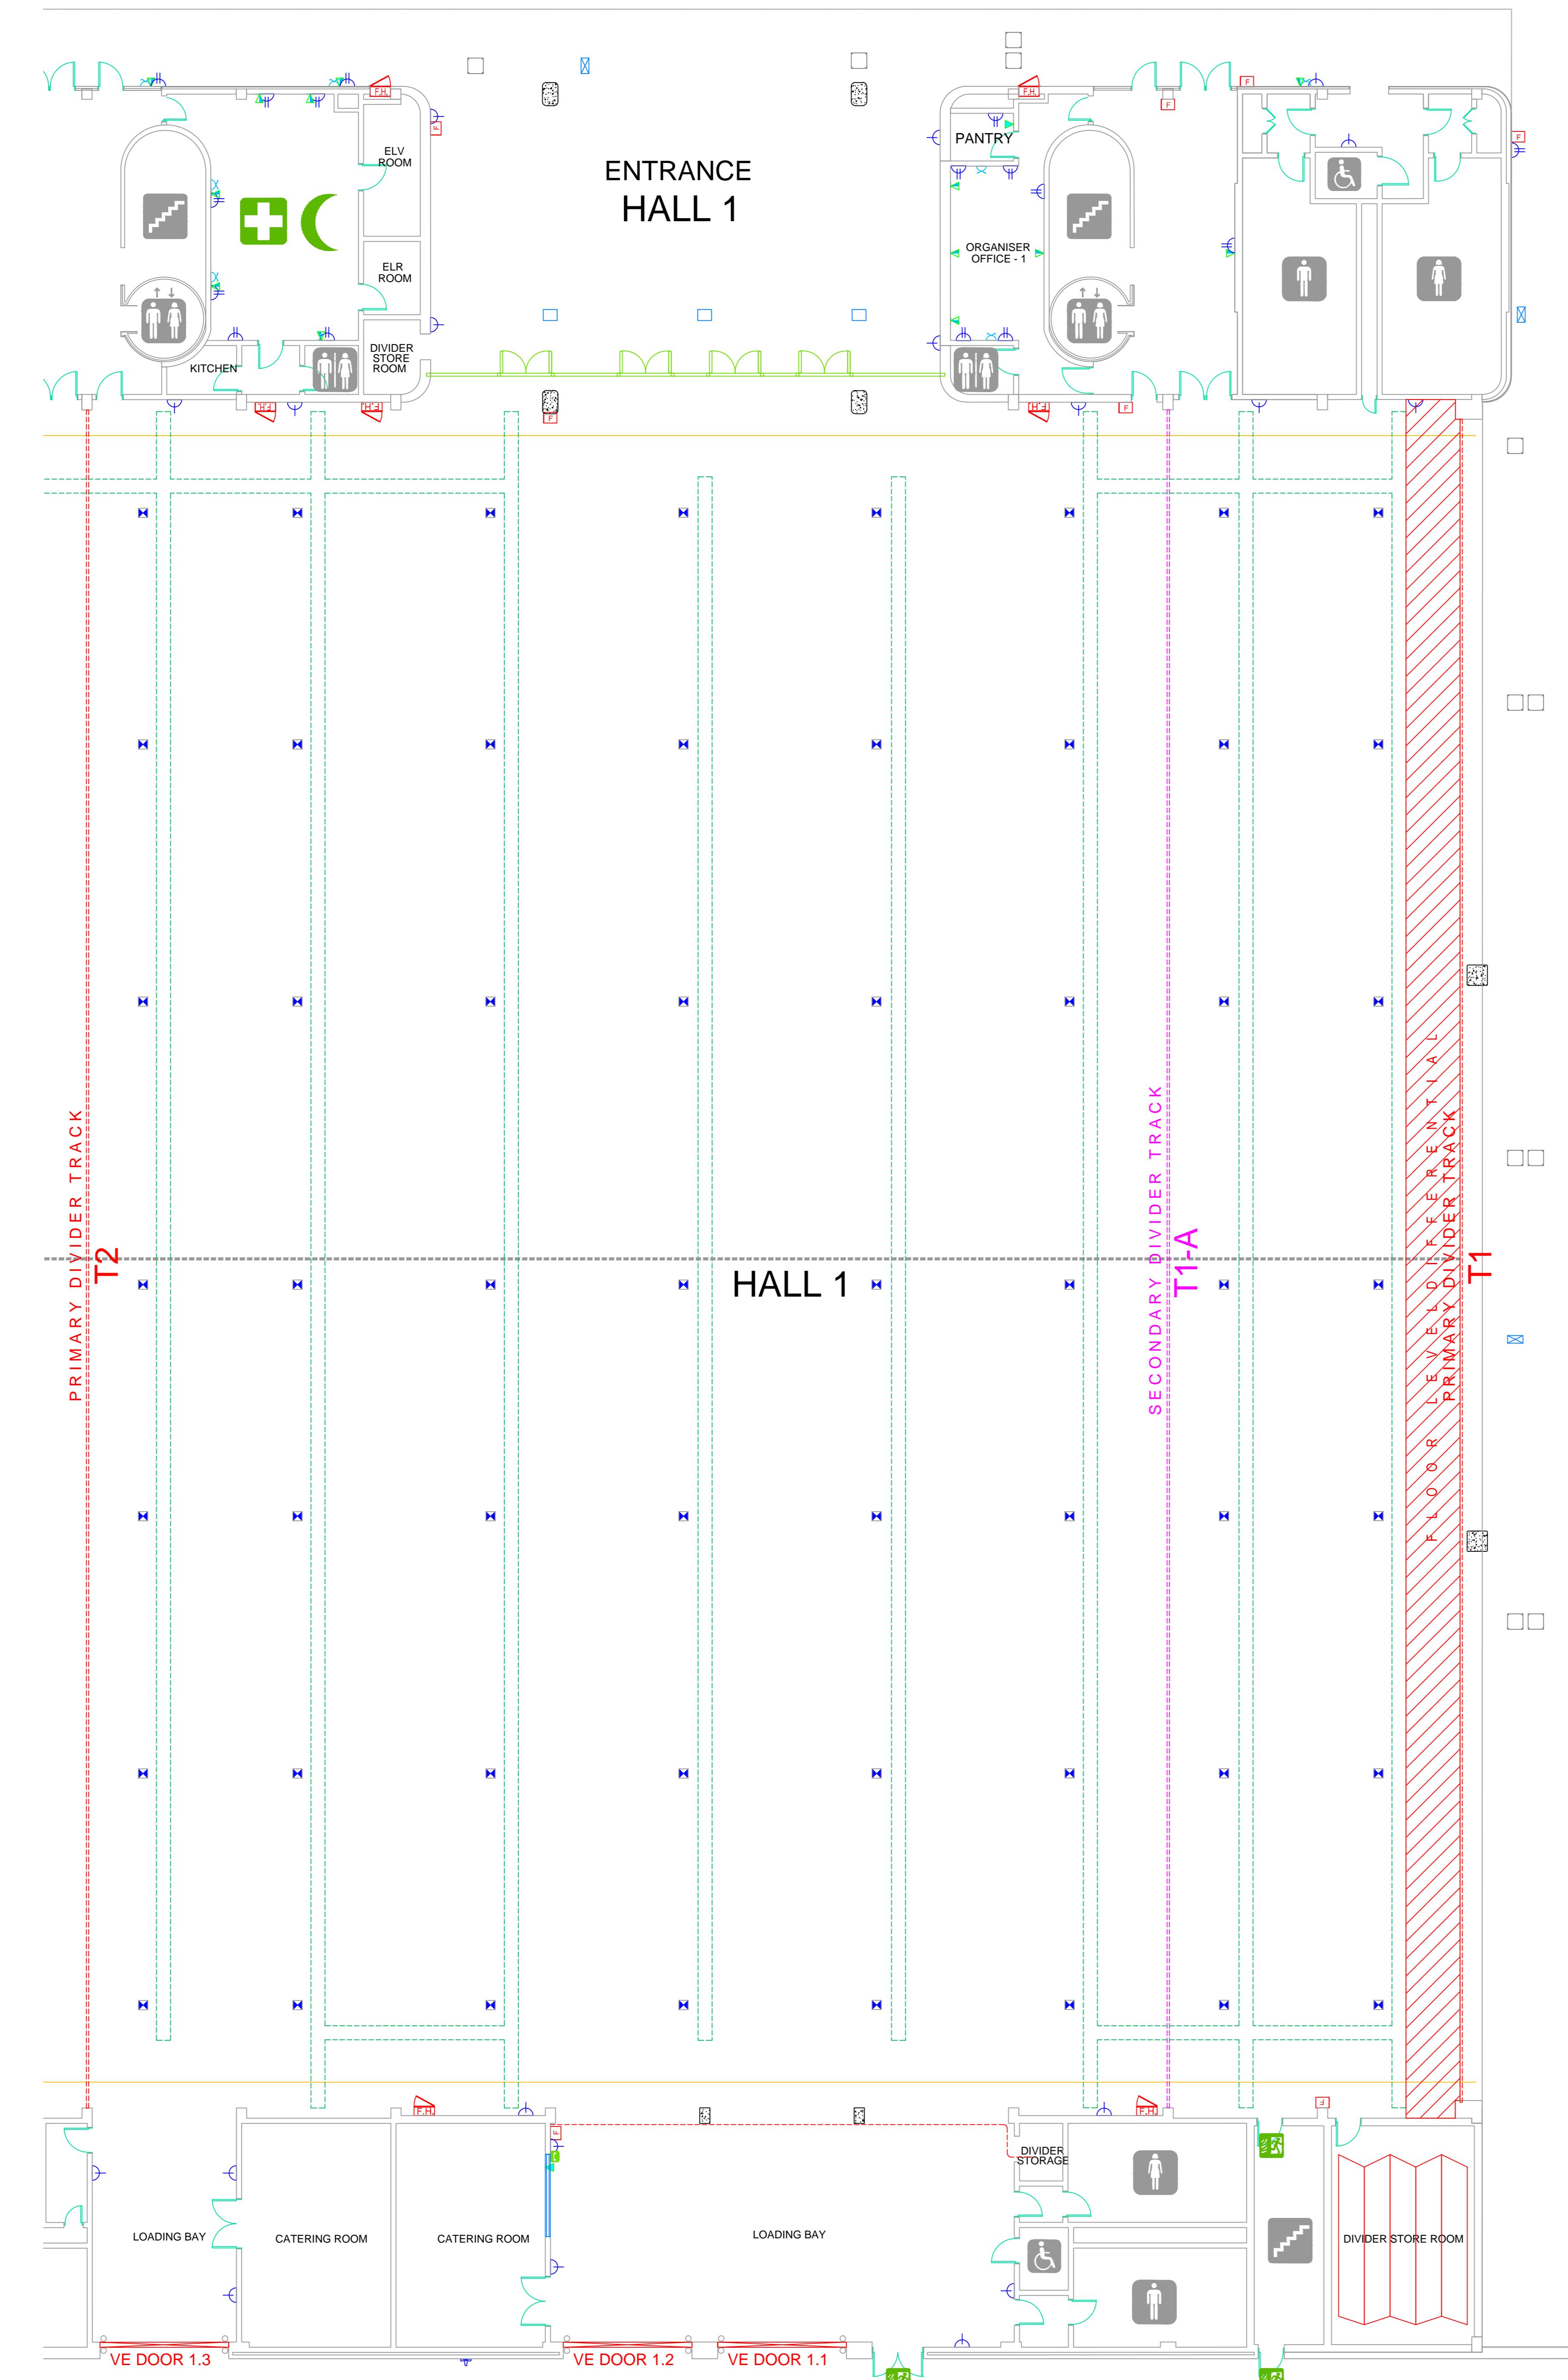


KEY PLAN: HALL 1

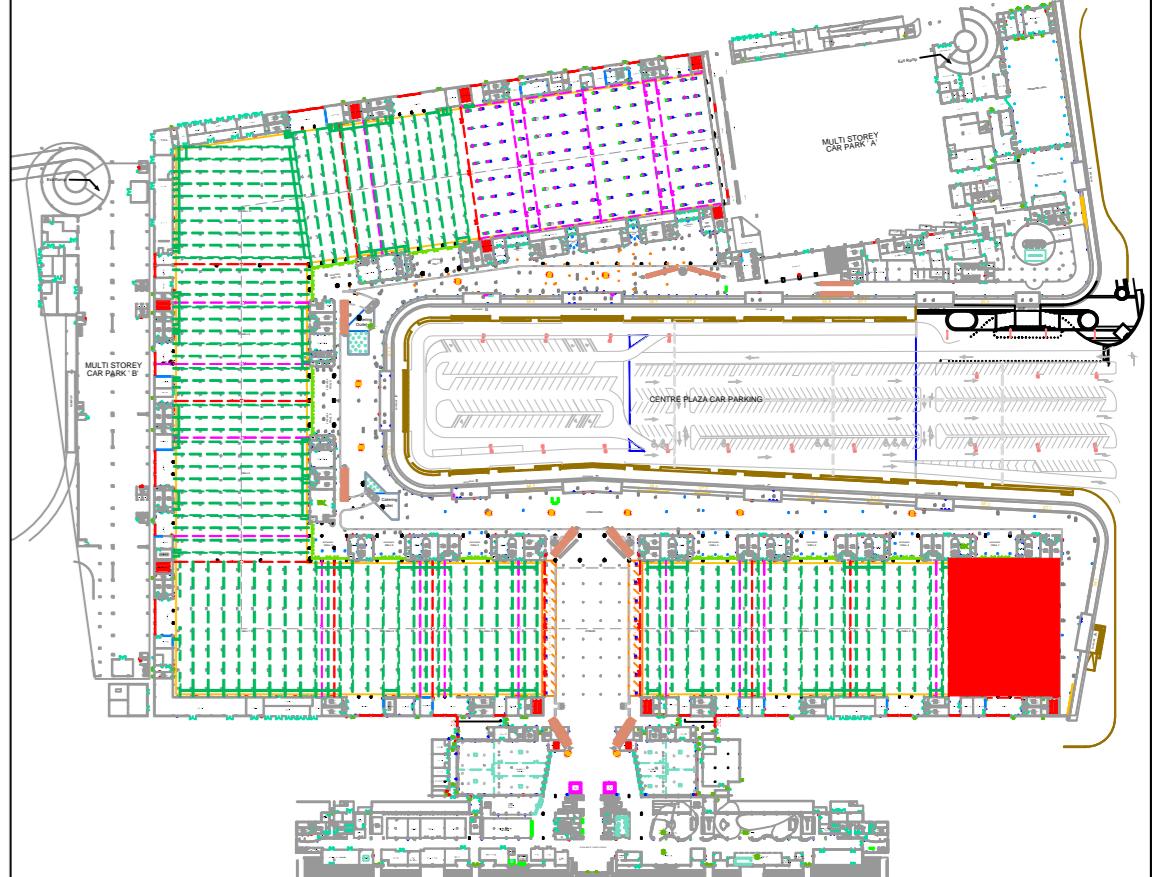

REV. #	REVISION	DATE	REVISED BY
1	AS PER SITE SURVEY	4/25/2011	Chris
2	ALOFT ENTRANCE AMMENDED, H12 FLOOR TRENCH & CENTRE PLAZA PARKING	05/01/2011	Chris

LEGEND:

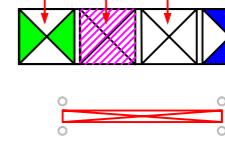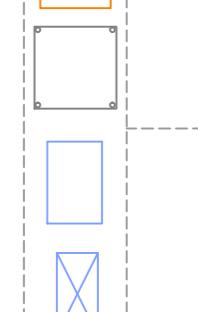	Staircase
	Male Toilet
	Female Toilet
	Lift / Elevator
	Toilet for Disabled
	Unisex Toilet
	Fire Hydrant
	Escalator
	Food Court
	Media Display
	VRO Desk
	Exit Door
	Medical Room
	Telephone Unit (Wall Mounted)
	Double Socket
	Data & Voice Port
	Voice Only
	TV Junction Box
	Single Socket
	Fire Alarm
	Fire Extinguisher
	Primary Hall Divider
	Secondary Hall Divider
	Water & Waste Floor Pits (Halls 1-11)
	Electrical Floor Trenches (Halls 1 - 11)
	Abu Dhabi Hall - Floor Service Pits
	VE Doors with Bollard
	Centre Plaza Lamp post
	Shutter Door
	Sectional Door
	Concourse Electrical, Water & Waste Floor Pits

© COPYRIGHT NOTICE

This drawing is provided in electronic format (.dwg file) for "information purposes" only without any liability on the part of ADNEC. The file, and its contents, remain the property of ADNEC, and shall not be reproduced or re-issued to any third party without express written authorisation from ADNEC.

The drawing is for reference only and may be subject to change without notice. Updates to this drawing may occur at undefined intervals and shall be notified at the sole discretion of ADNEC. Users are responsible for ensuring that critical dimensions and features are independently verified prior to commencement of any works.

DRAWING TITLE: A D N E C
AS BUILT - GROUND FLOOR
GENERAL ARRANGEMENT

SCALE: 1:125@A0 DRAWING NO. ADNEC-VGF01-GA

DATE:	16-01-12
-------	----------

APPROVED BY:	Adrian Finn
DRAWN BY:	

Chris Lopez

A graphic element consisting of three thick, light blue diagonal stripes of varying lengths, positioned in the bottom right corner of the slide.


ADNEC

ADNEC 阿联酋国际会展中心


Abu Dhabi National Exhibitions Company

11 of 11

KEY PLAN: HALL 2

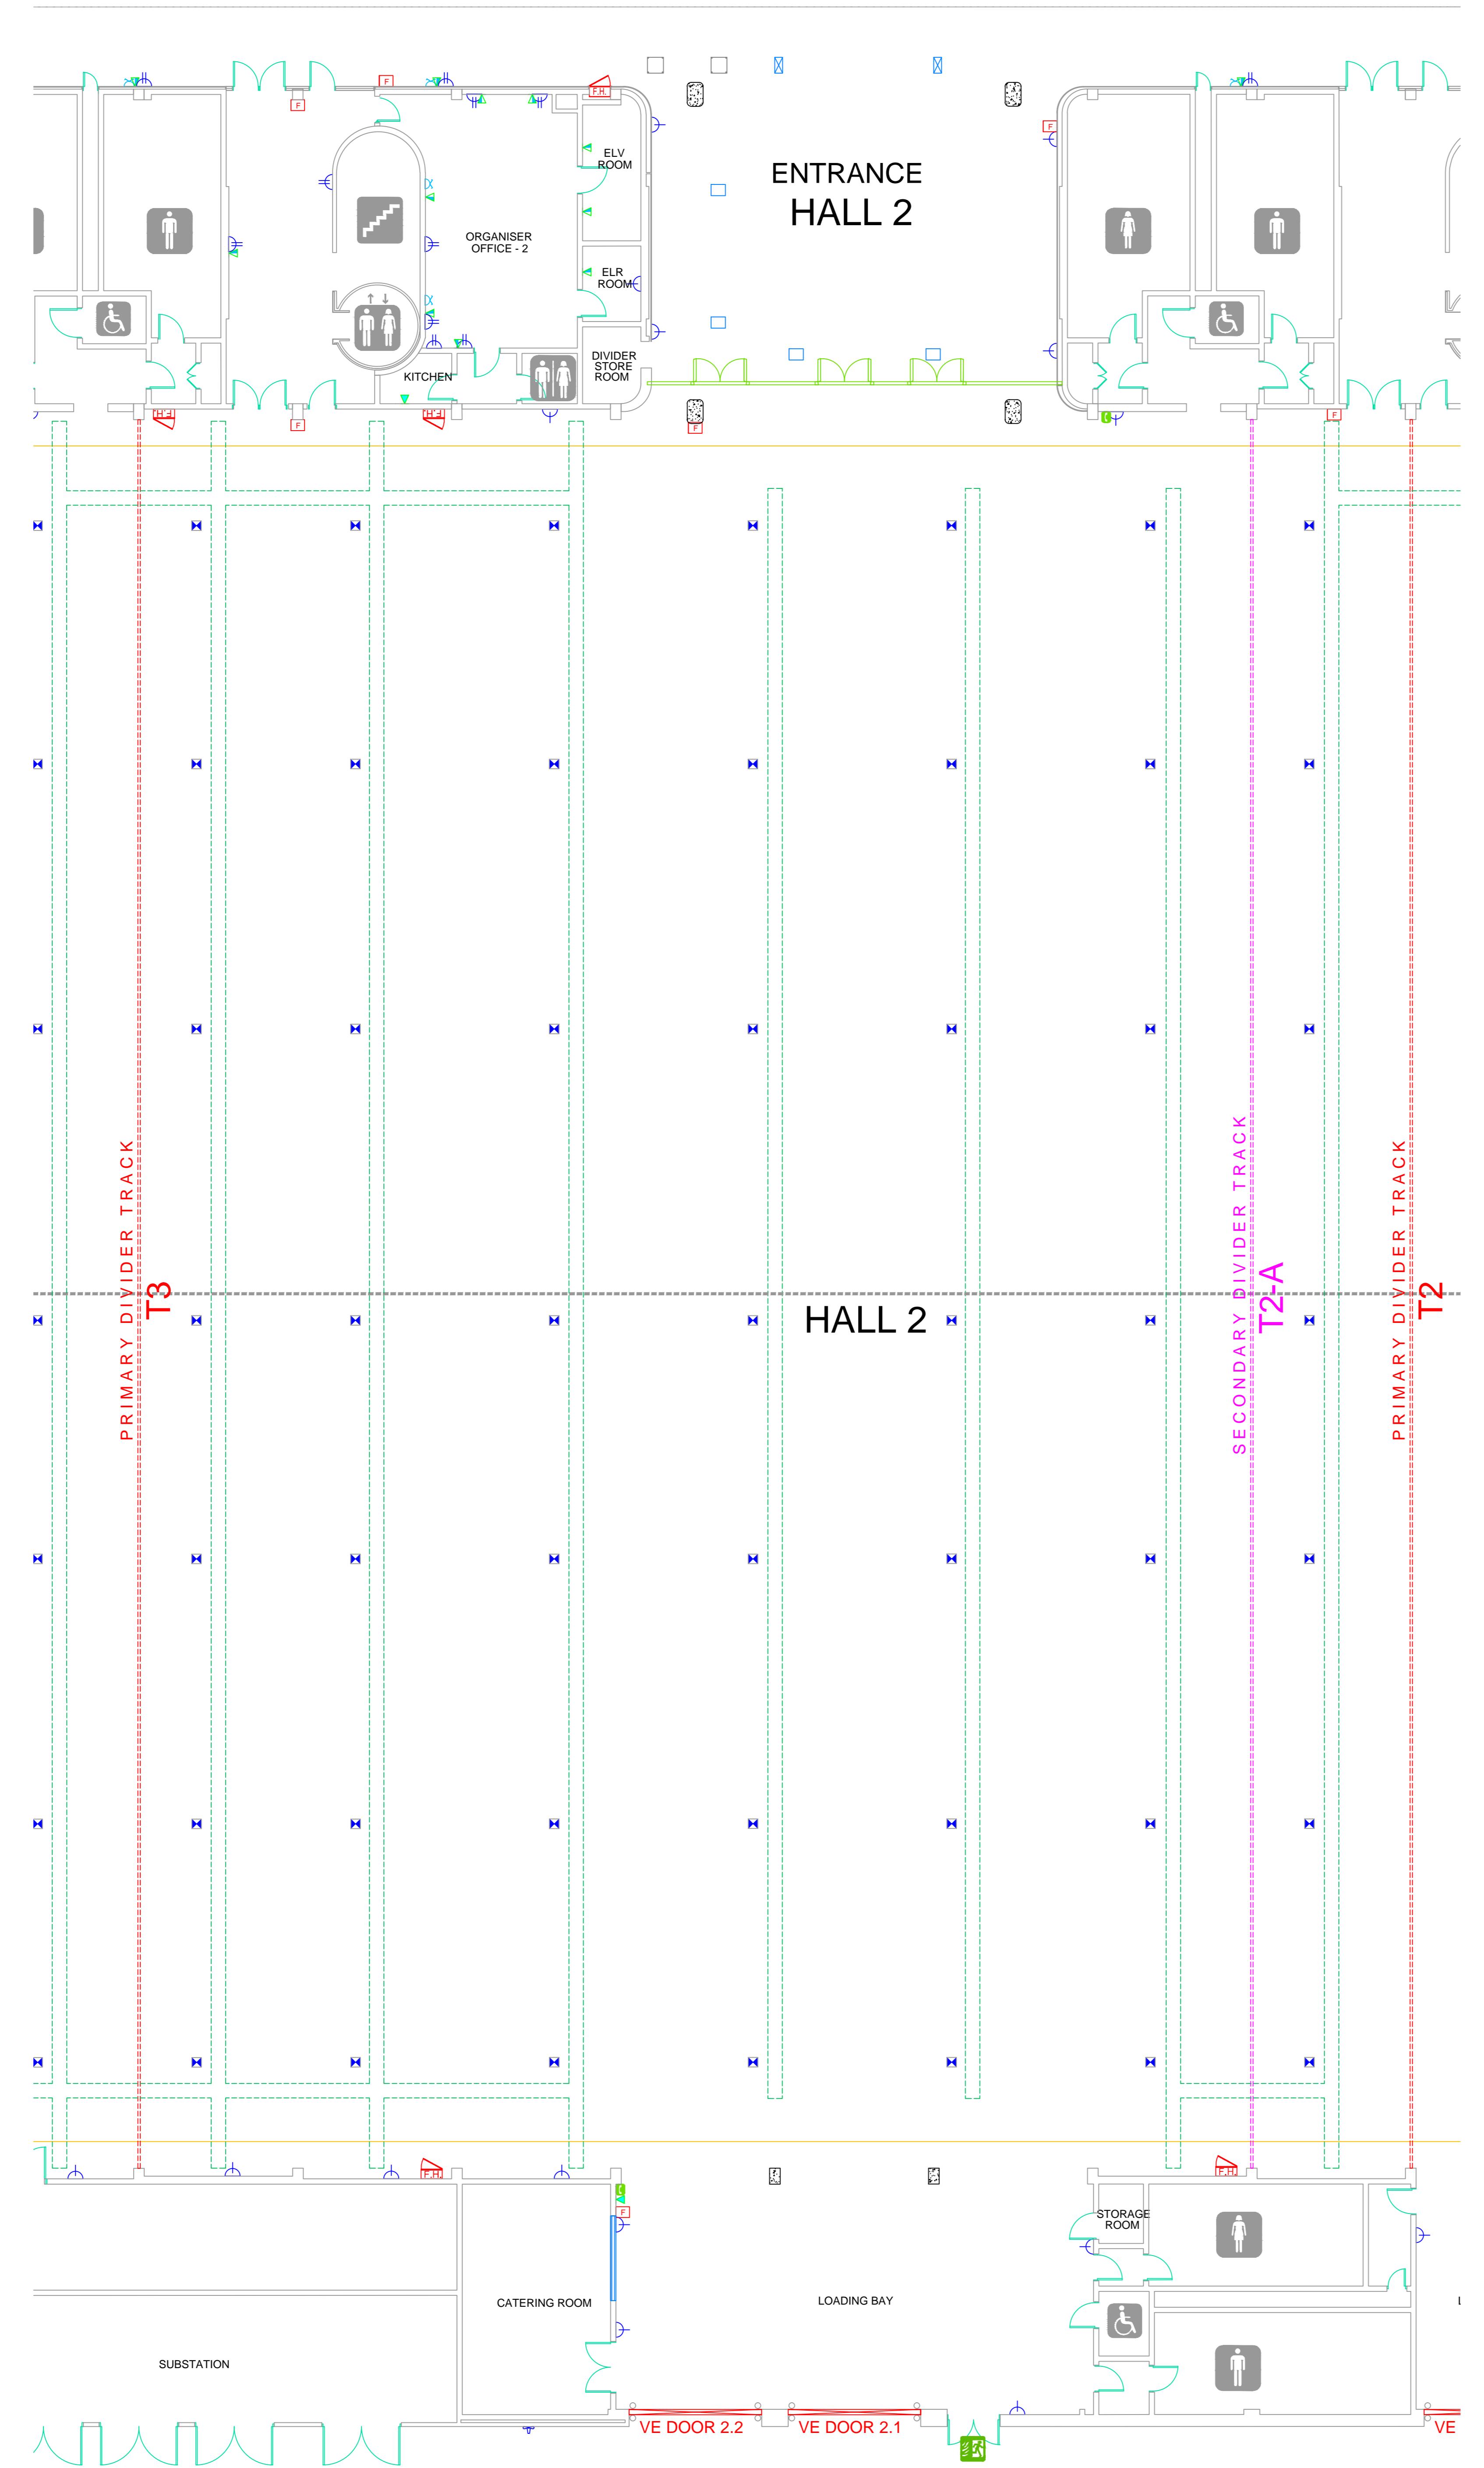

REV. #	REVISION	DATE	REVISED BY
1	AS PER SITE SURVEY	4/25/2011	Chris
2	ALOFT ENTRANCE AMENDED, H12 FLOOR TRENCH & CENTRE PLAZA PARKING	05/01/2011	Chris

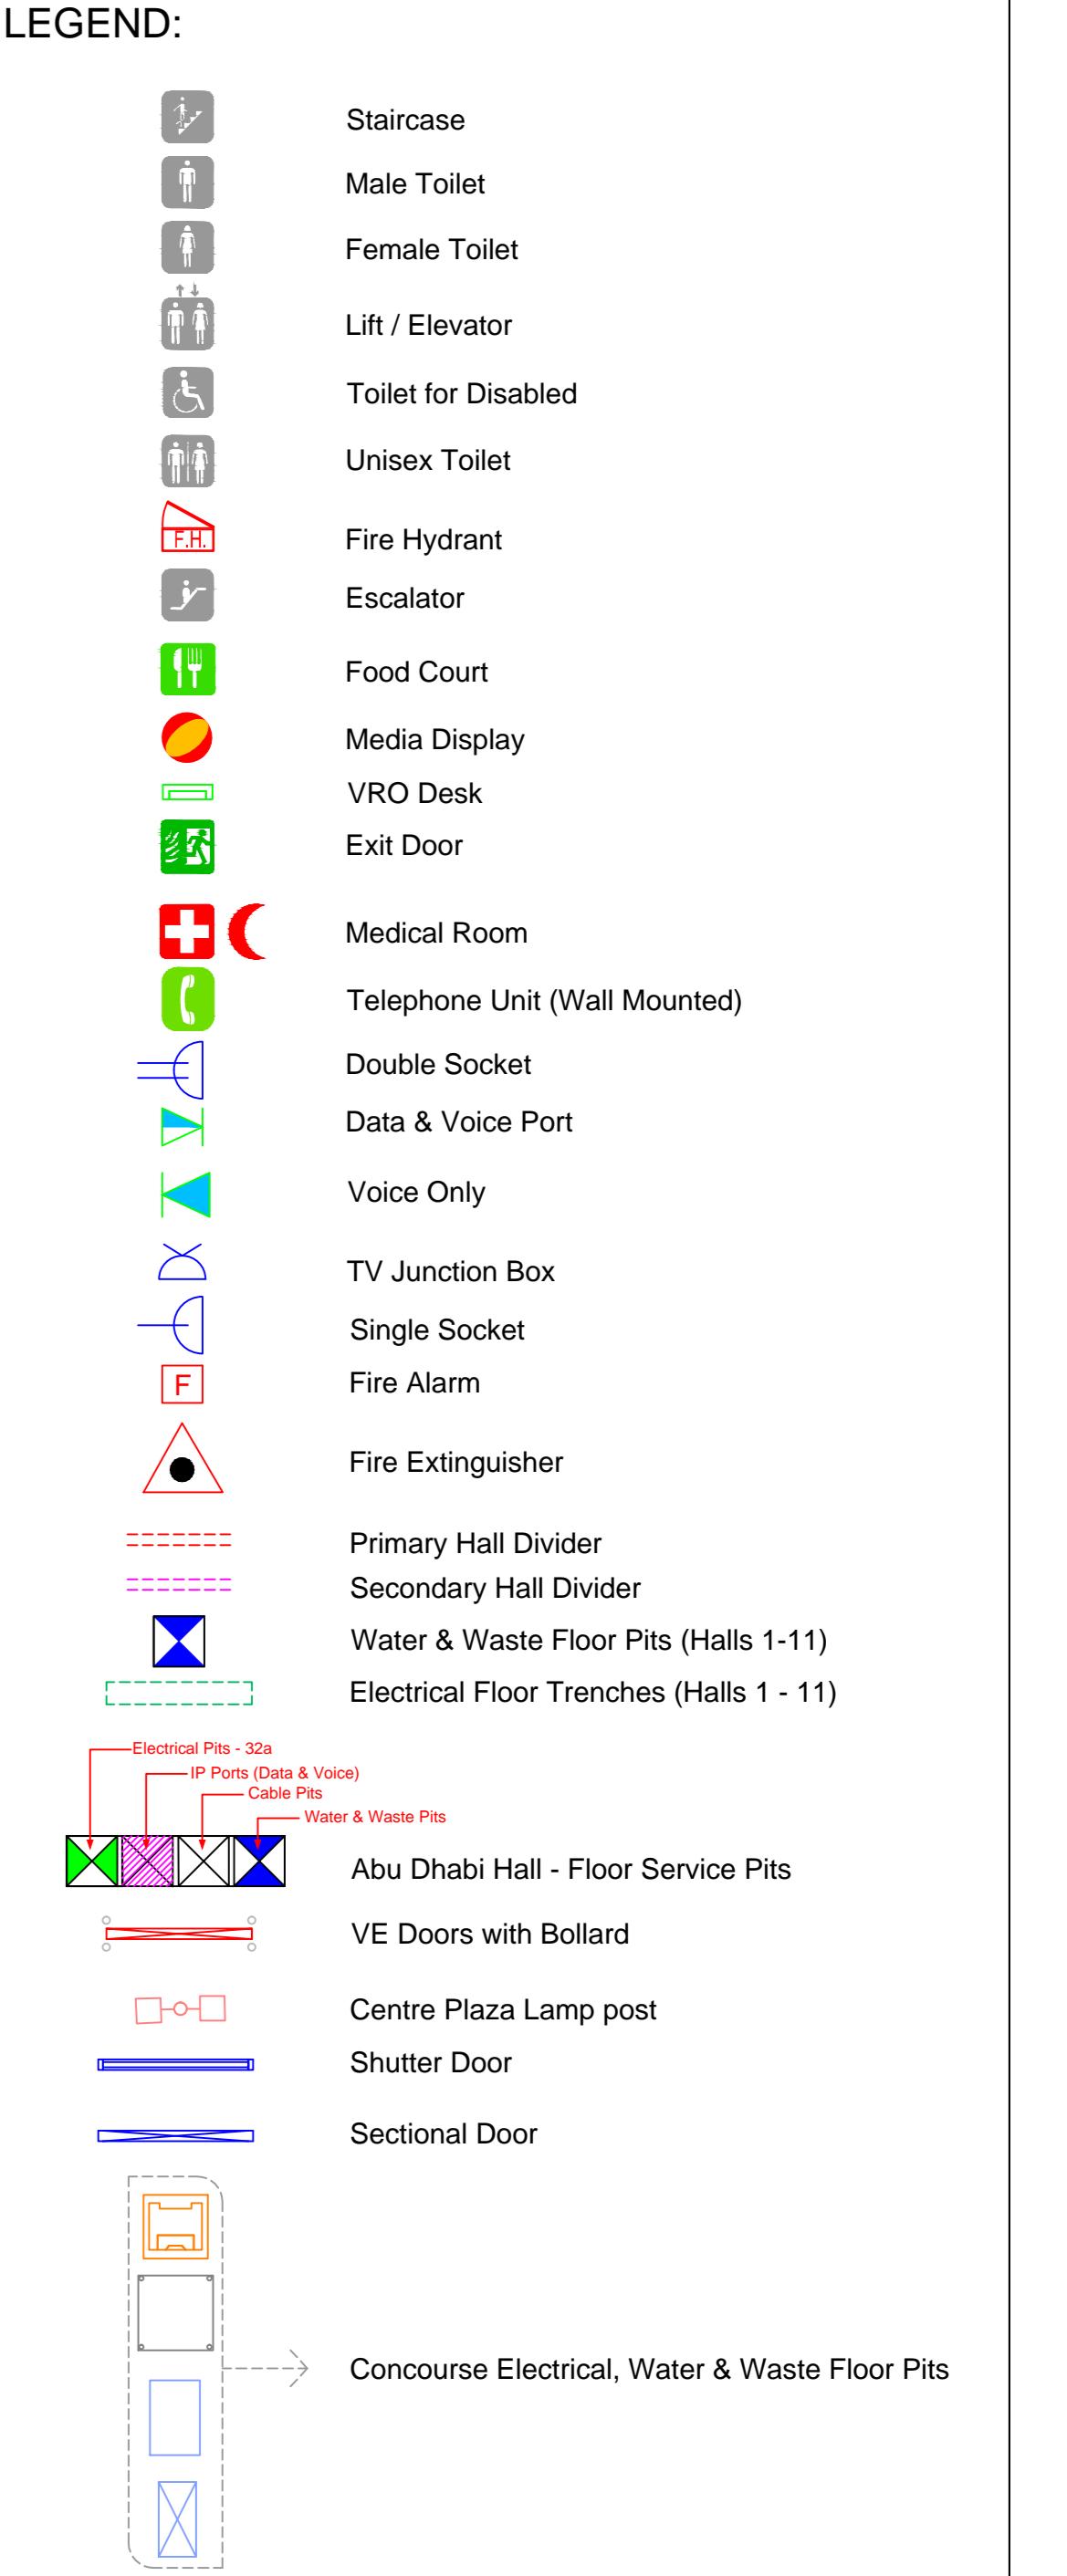

© COPYRIGHT NOTICE
 This drawing is provided in electronic format (.dwg file) for "information purposes" only without any liability on the part of ADNEC. The file, and its contents, remain the property of ADNEC, and shall not be reproduced or re-issued to any third party without express written authorisation from ADNEC.
 The drawing is for reference only and may be subject to change without notice. Updates to this drawing may occur at undefined intervals and shall be notified at the sole discretion of ADNEC. Users are responsible for ensuring that critical dimensions and features are independently verified prior to commencement of any works.

DRAWING TITLE: ADNEC
AS BUILT - GROUND FLOOR GENERAL ARRANGEMENT



SCALE: 1:125 @ A0 **DRAWING NO.** ADNEC-VGF01-GA

DATE: 16-01-12

APPROVED BY: Adrian Finn


DRAWN BY: Chris Lopez

KEY PLAN: HALL 3

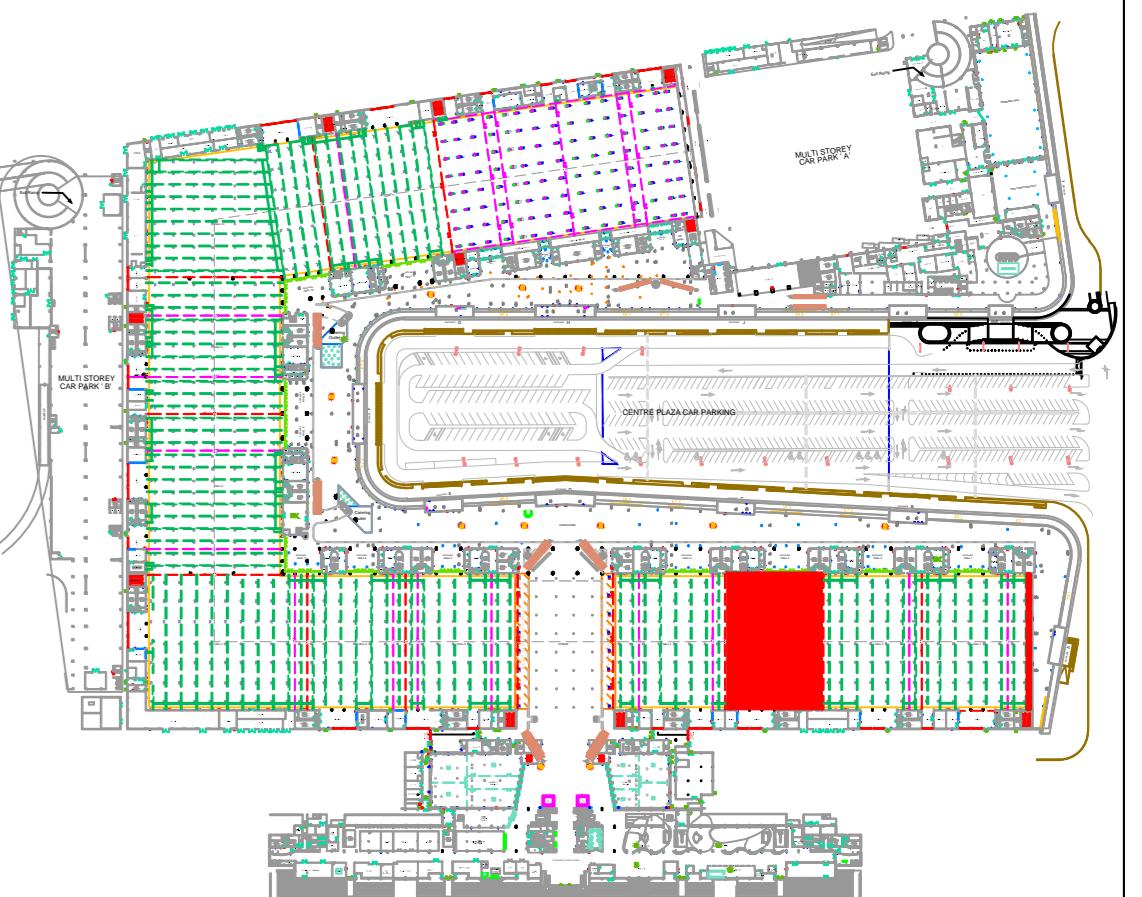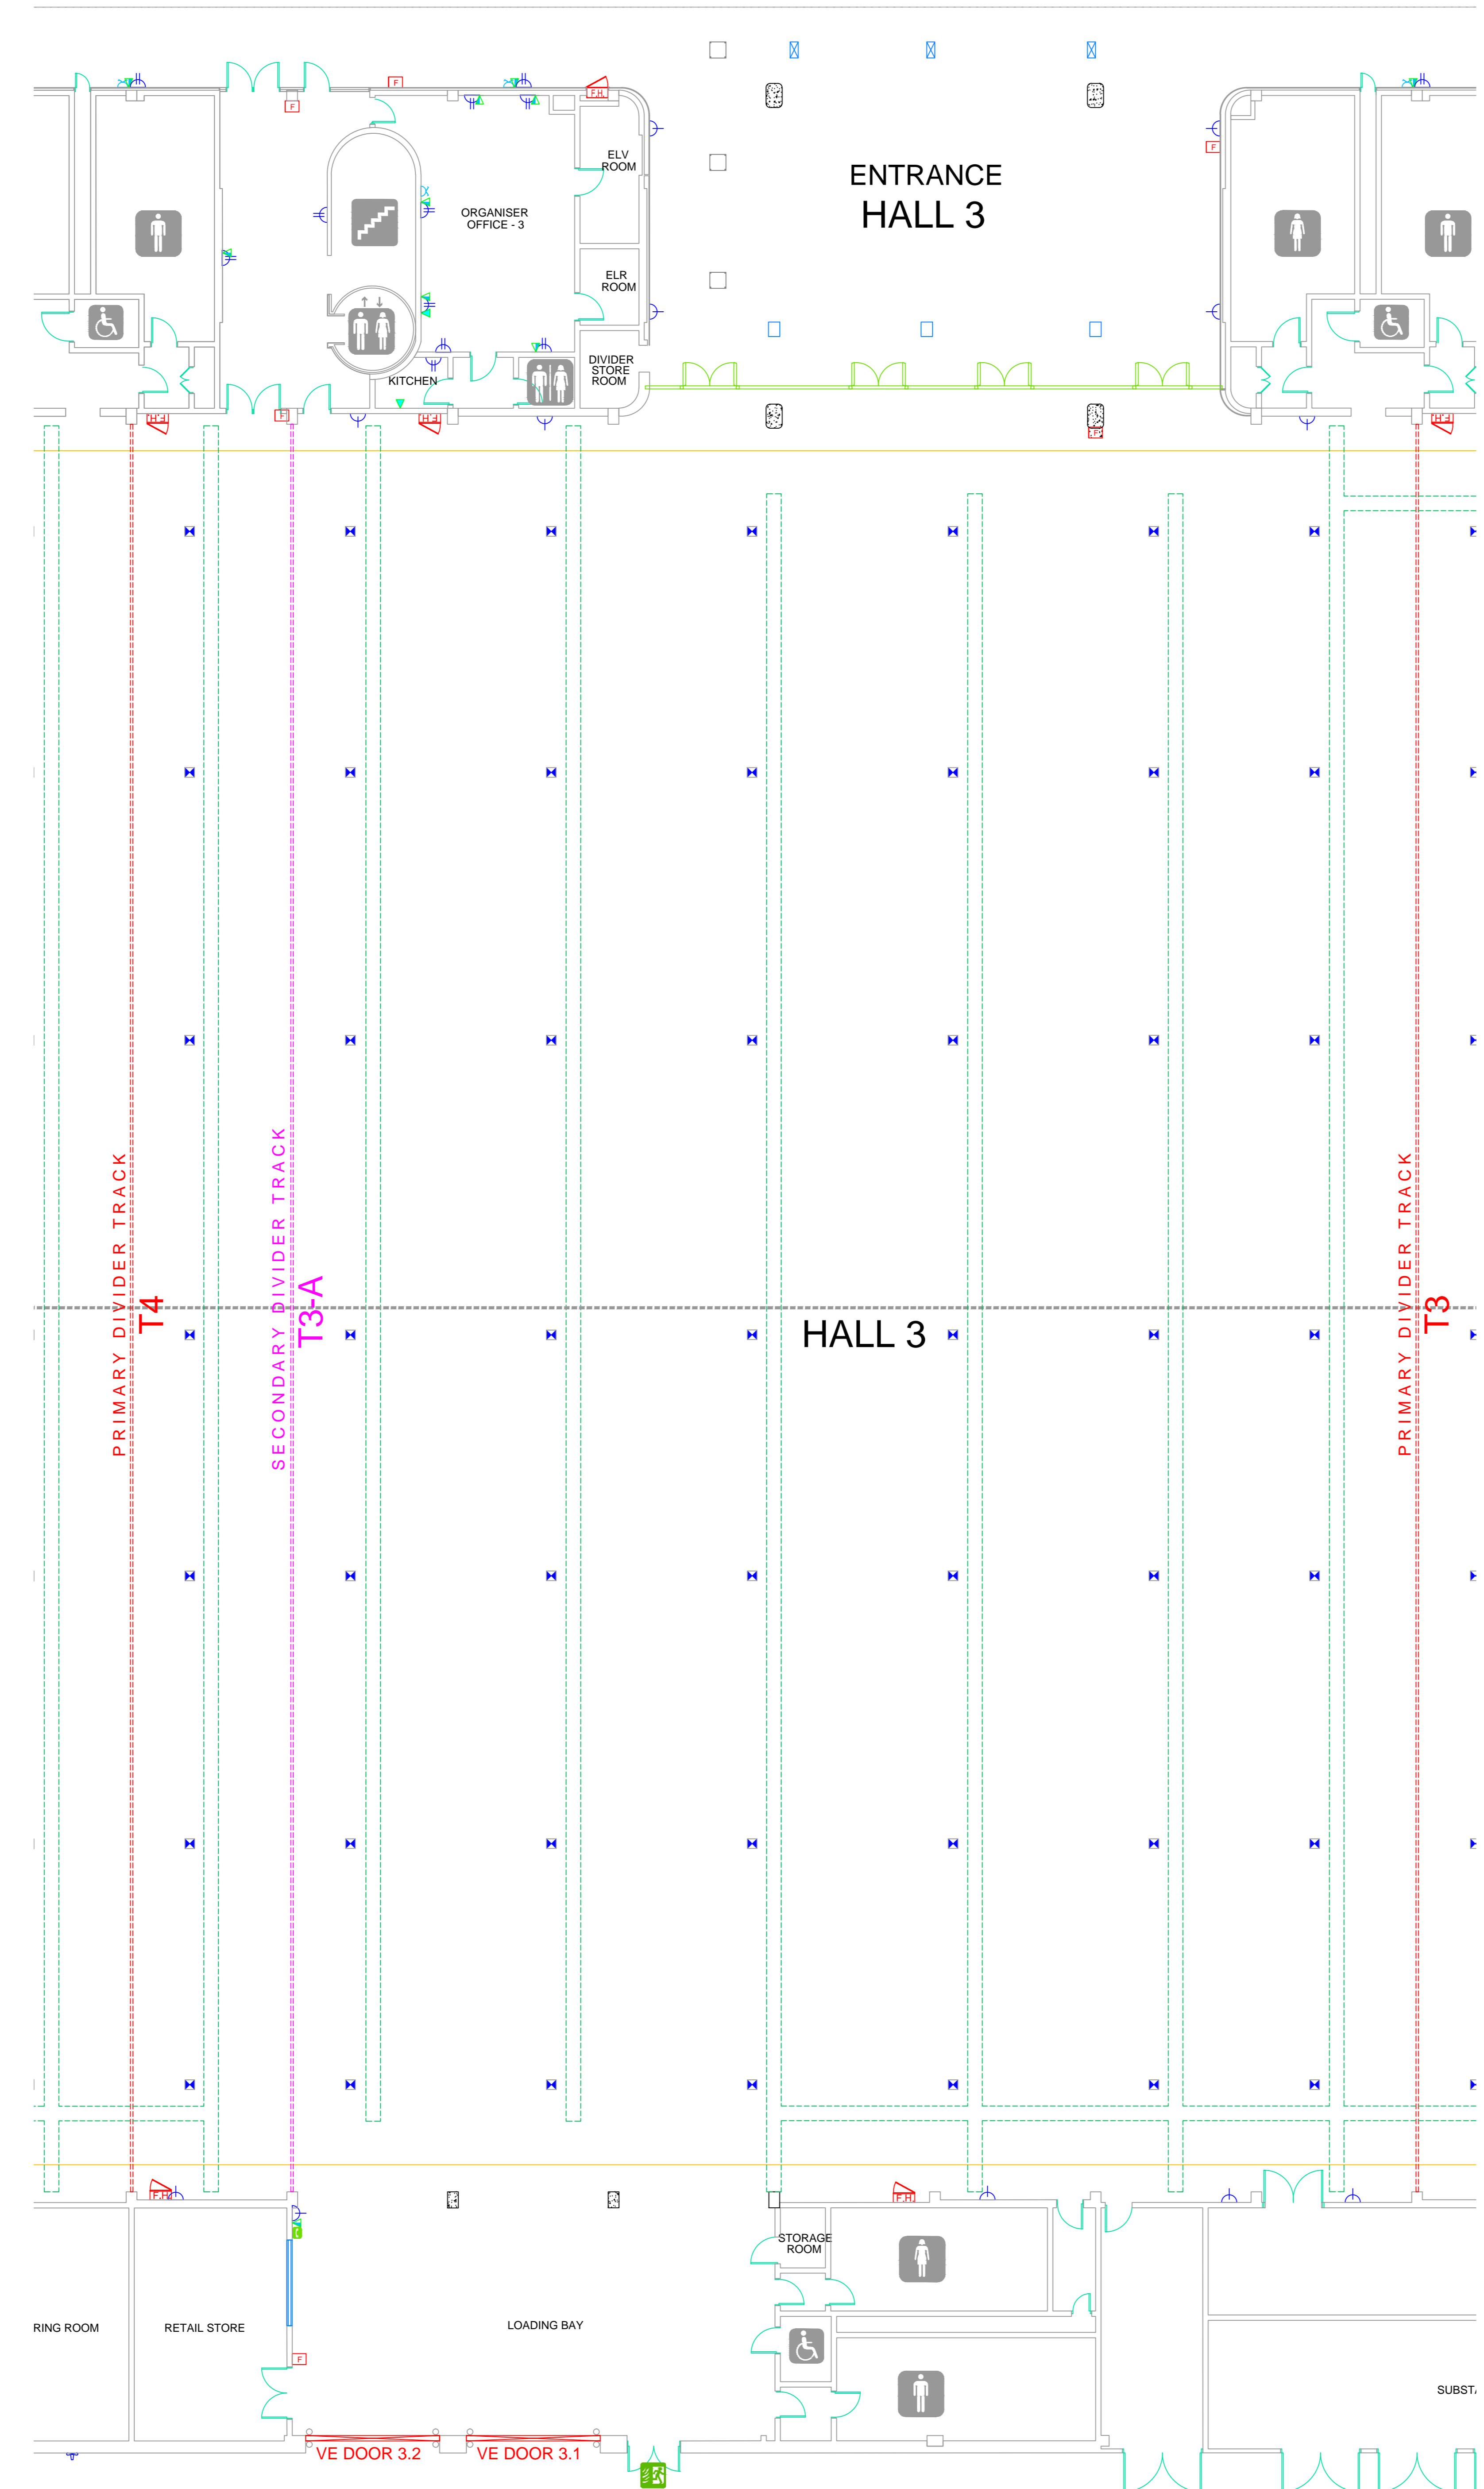

REV. #	REVISION	DATE	REVISED BY
1	AS PER SITE SURVEY	4/25/2011	Chris
2	ALOFT ENTRANCE AMENDED, H12 FLOOR TRENCH & CENTRE PLAZA PARKING	05/01/2011	Chris

LEGEND:

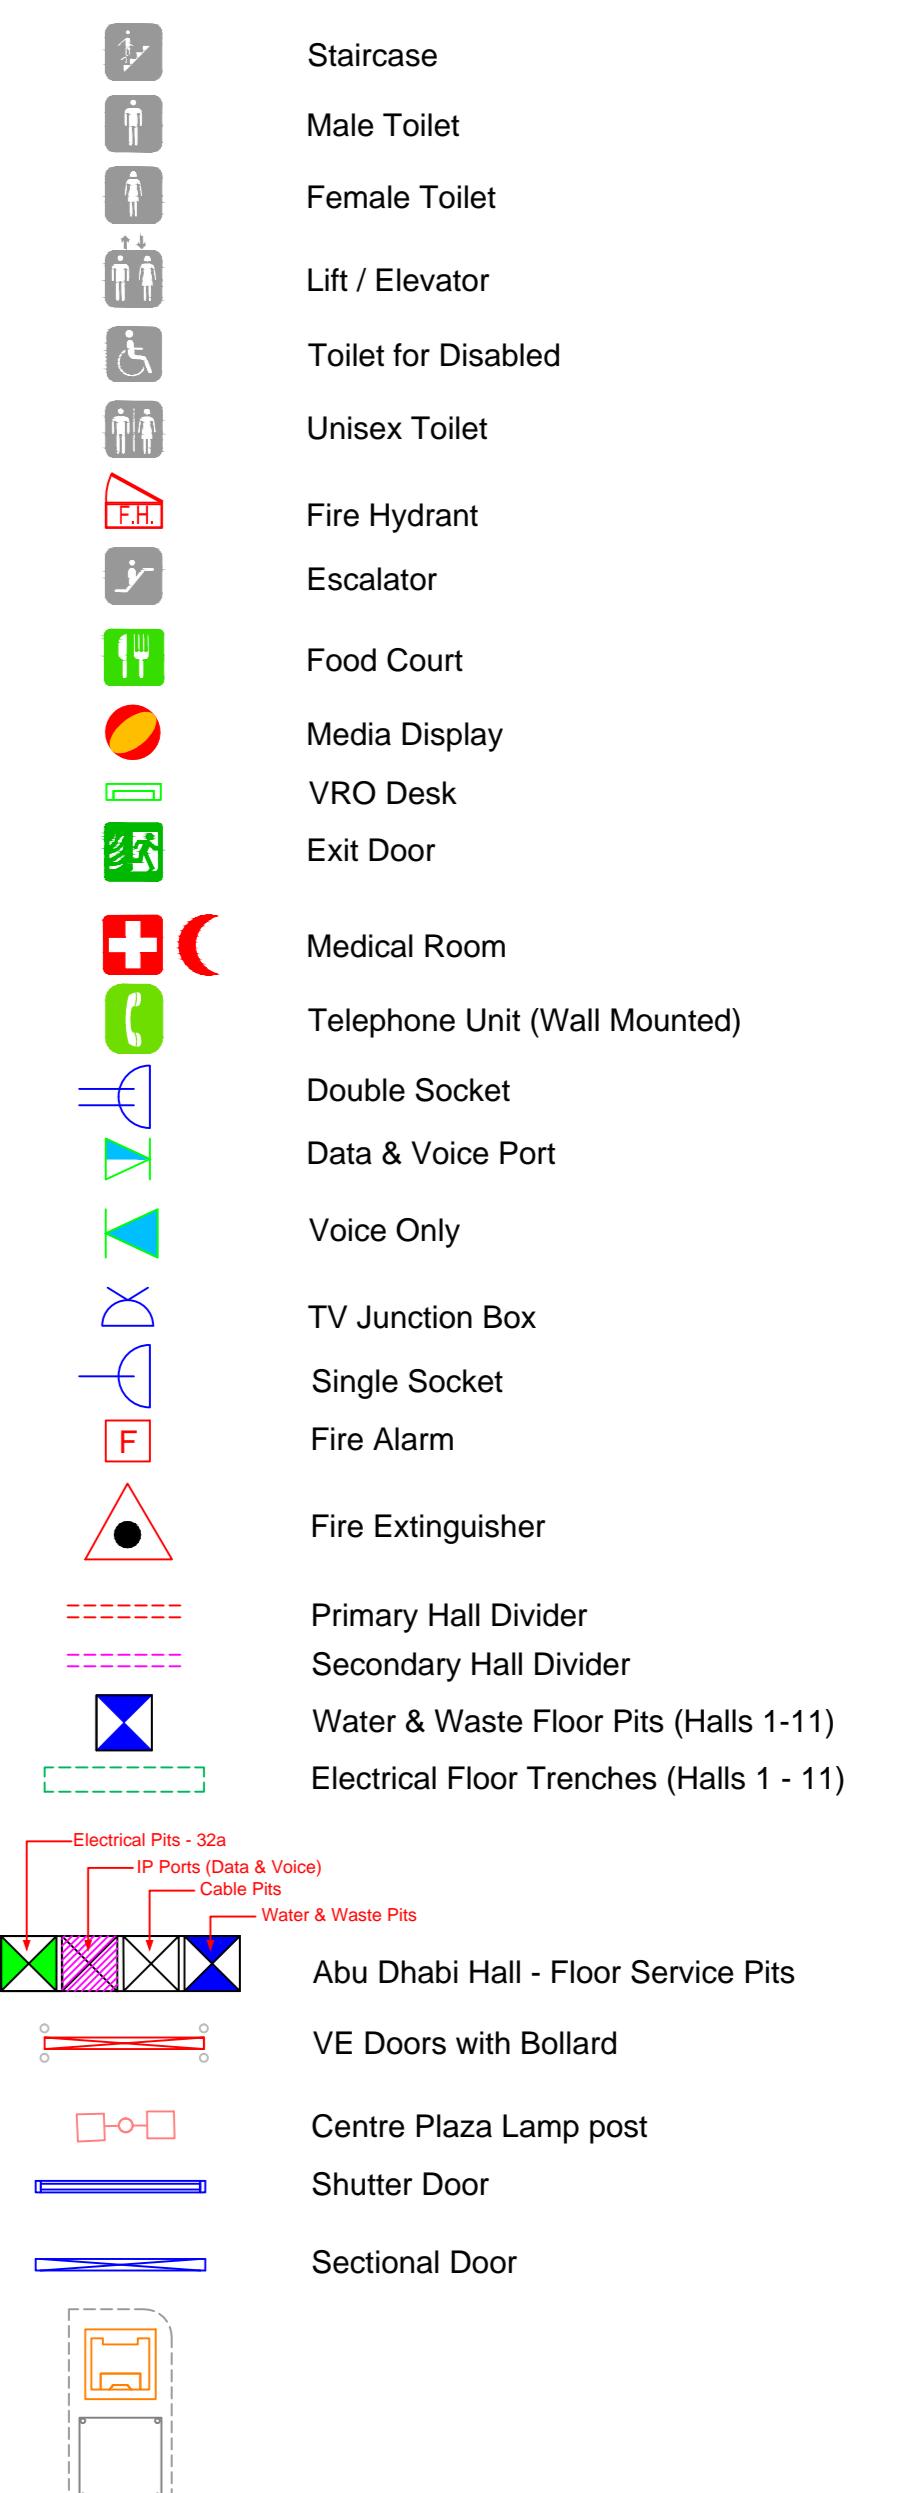

© COPYRIGHT NOTICE
 This drawing is provided in electronic format (.dwg file) for "information purposes" only without any liability on the part of ADNEC. The file, and its contents, remain the property of ADNEC, and shall not be reproduced or re-issued to any third party without express written authorisation from ADNEC.

The drawing is for reference only and may be subject to change without notice. Updates to this drawing may occur at undefined intervals and shall be notified at the sole discretion of ADNEC. Users are responsible for ensuring that critical dimensions and features are independently verified prior to commencement of any works.

DRAWING TITLE: ADNEC
AS BUILT - GROUND FLOOR GENERAL ARRANGEMENT



SCALE: 1:125 @ A0 **DRAWING NO.** ADNEC-VGF01-GA

DATE: 16-01-12

APPROVED BY: Adrian Finn


DRAWN BY: Chris Lopez

KEY PLAN: HALL 4

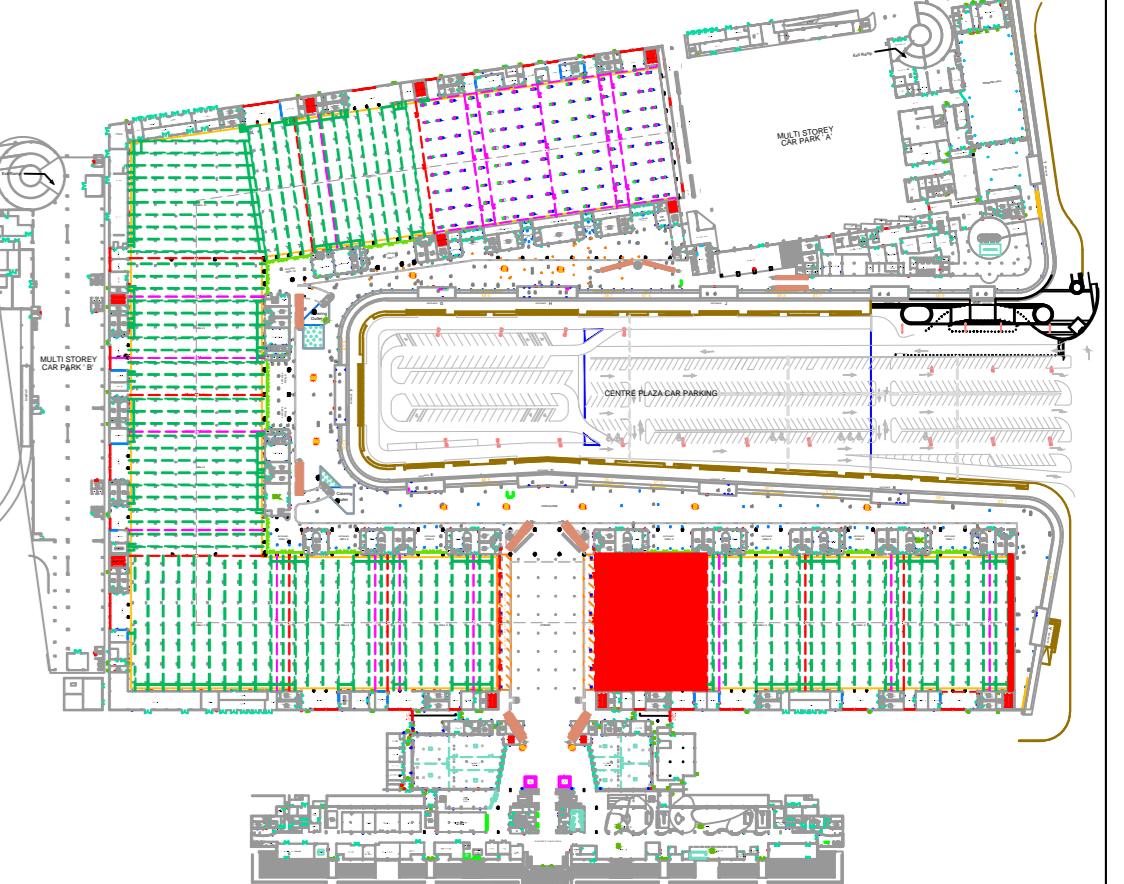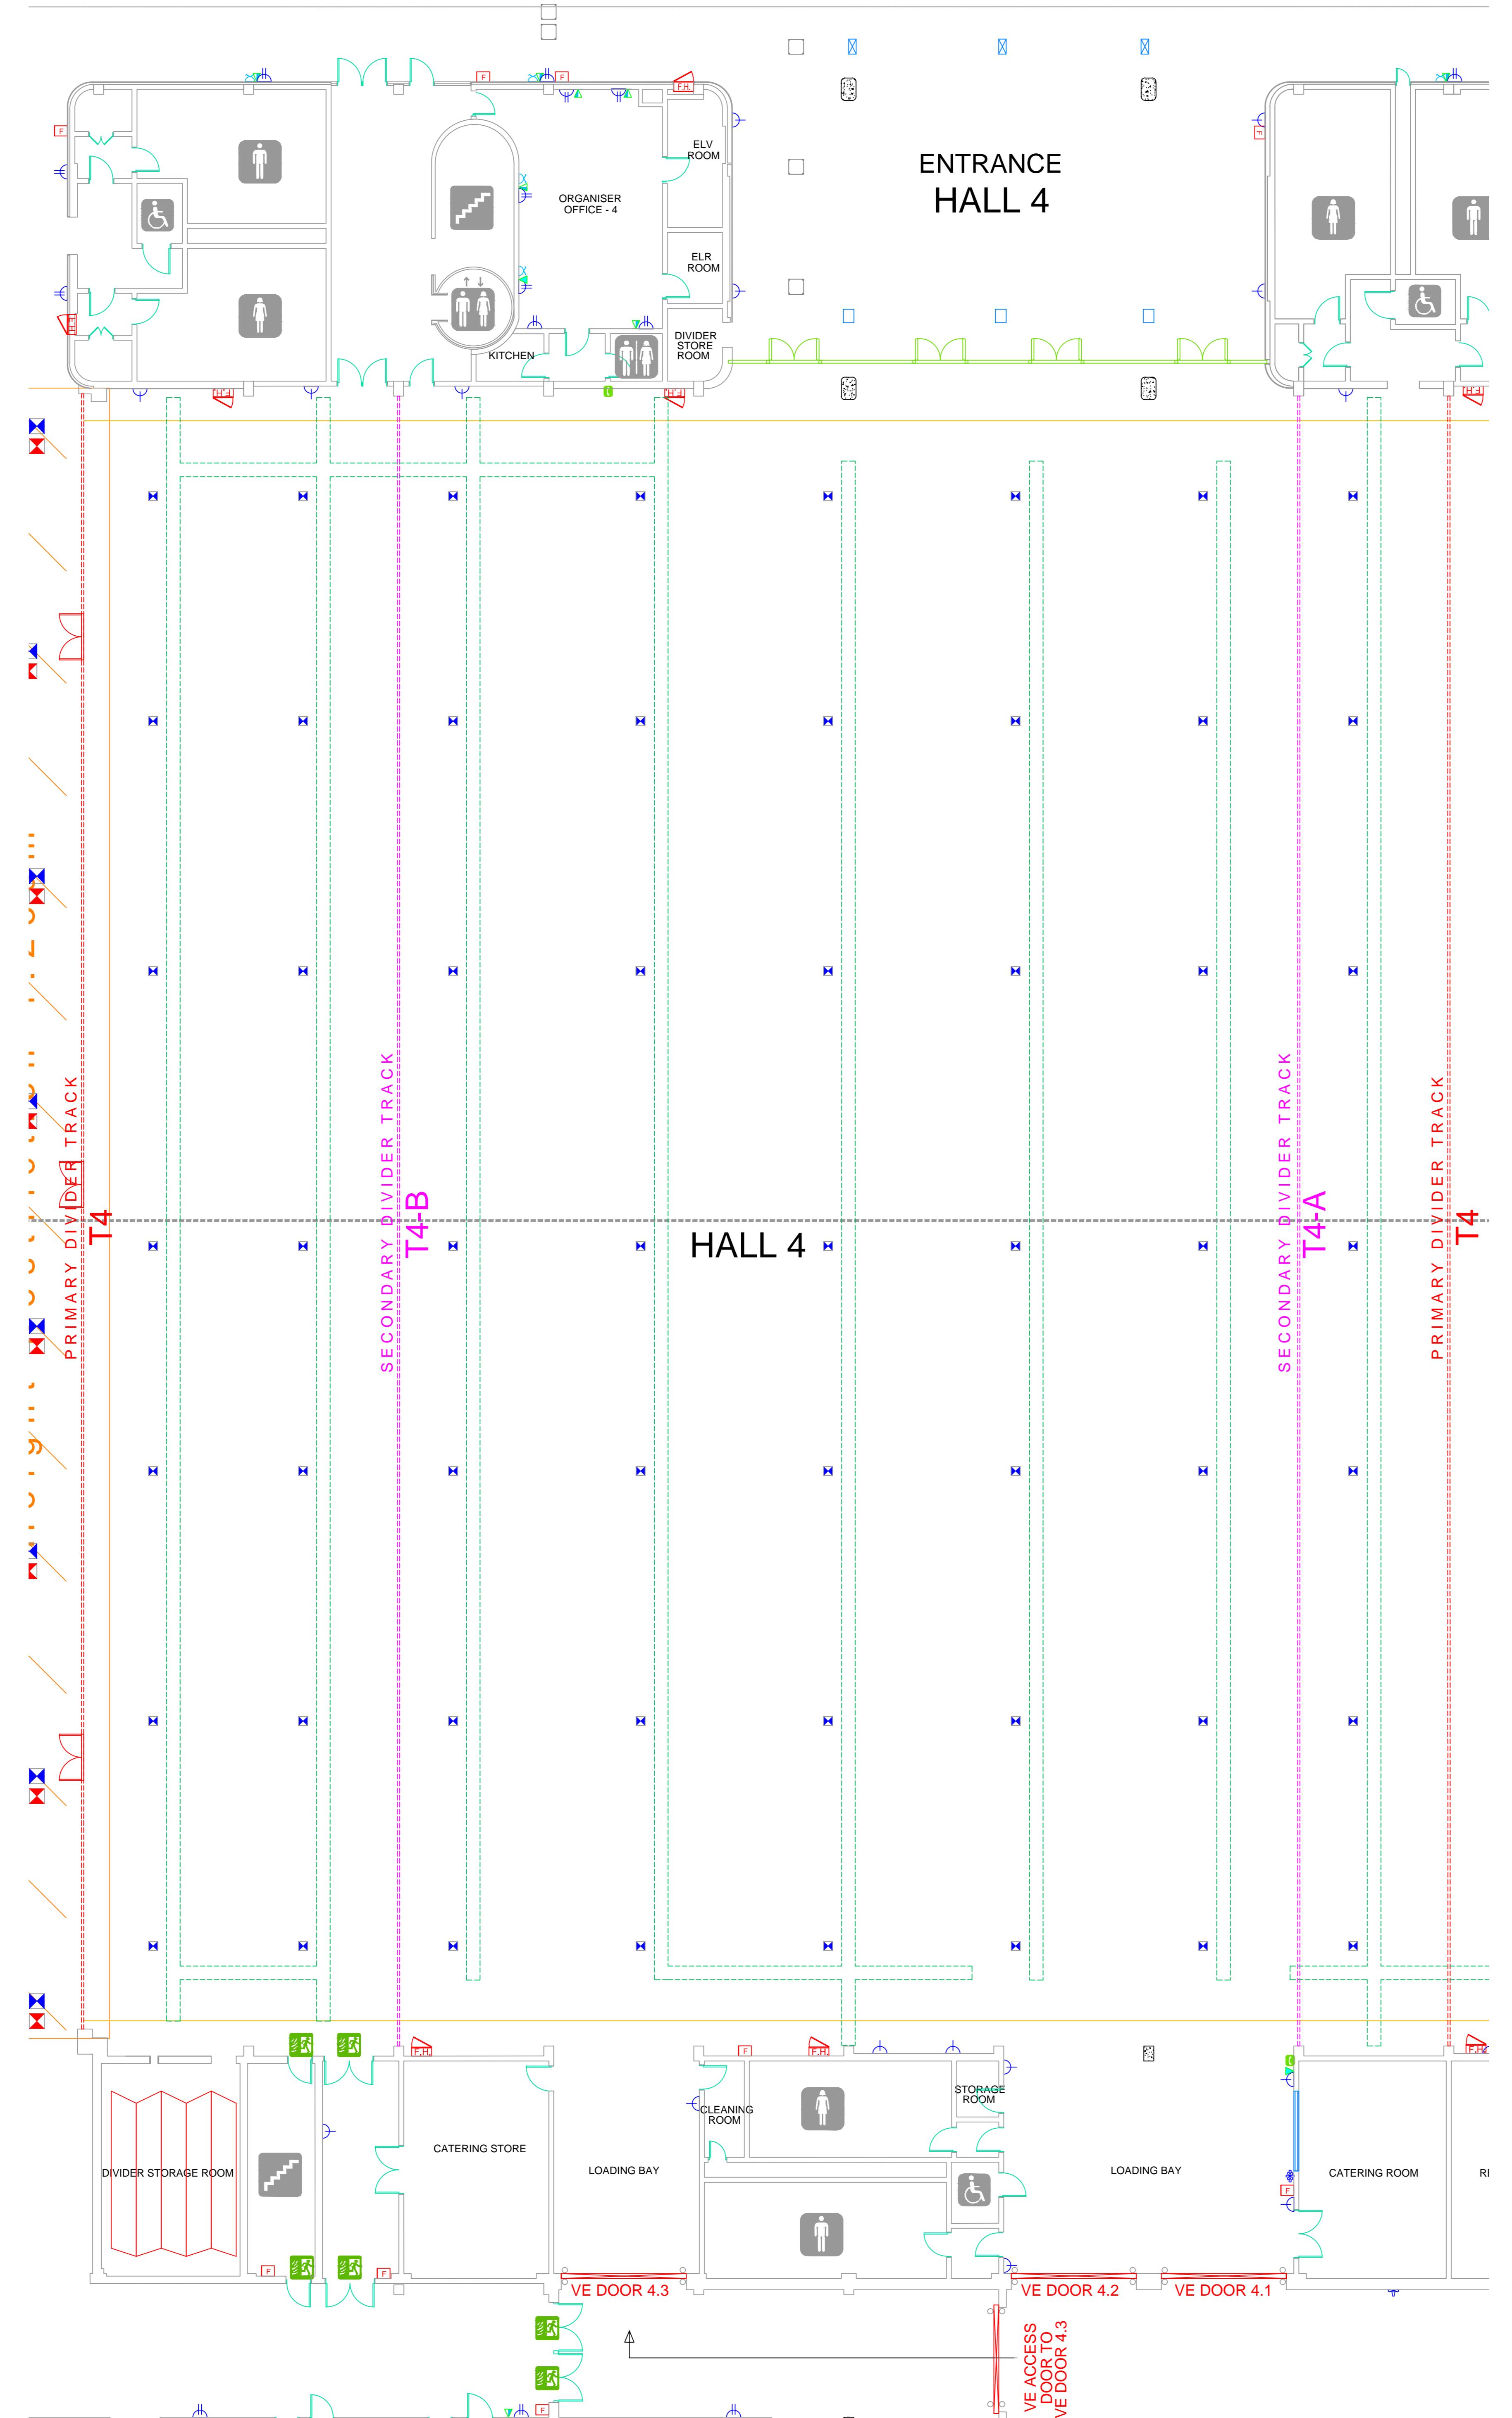

REV. #	REVISION	DATE	REVISED BY
1	AS PER SITE SURVEY	4/25/2011	Chris
2	ALOFT ENTRANCE AMENDED, H12 FLOOR TRENCH & CENTRE PLAZA PARKING	05/01/2011	Chris

LEGEND:

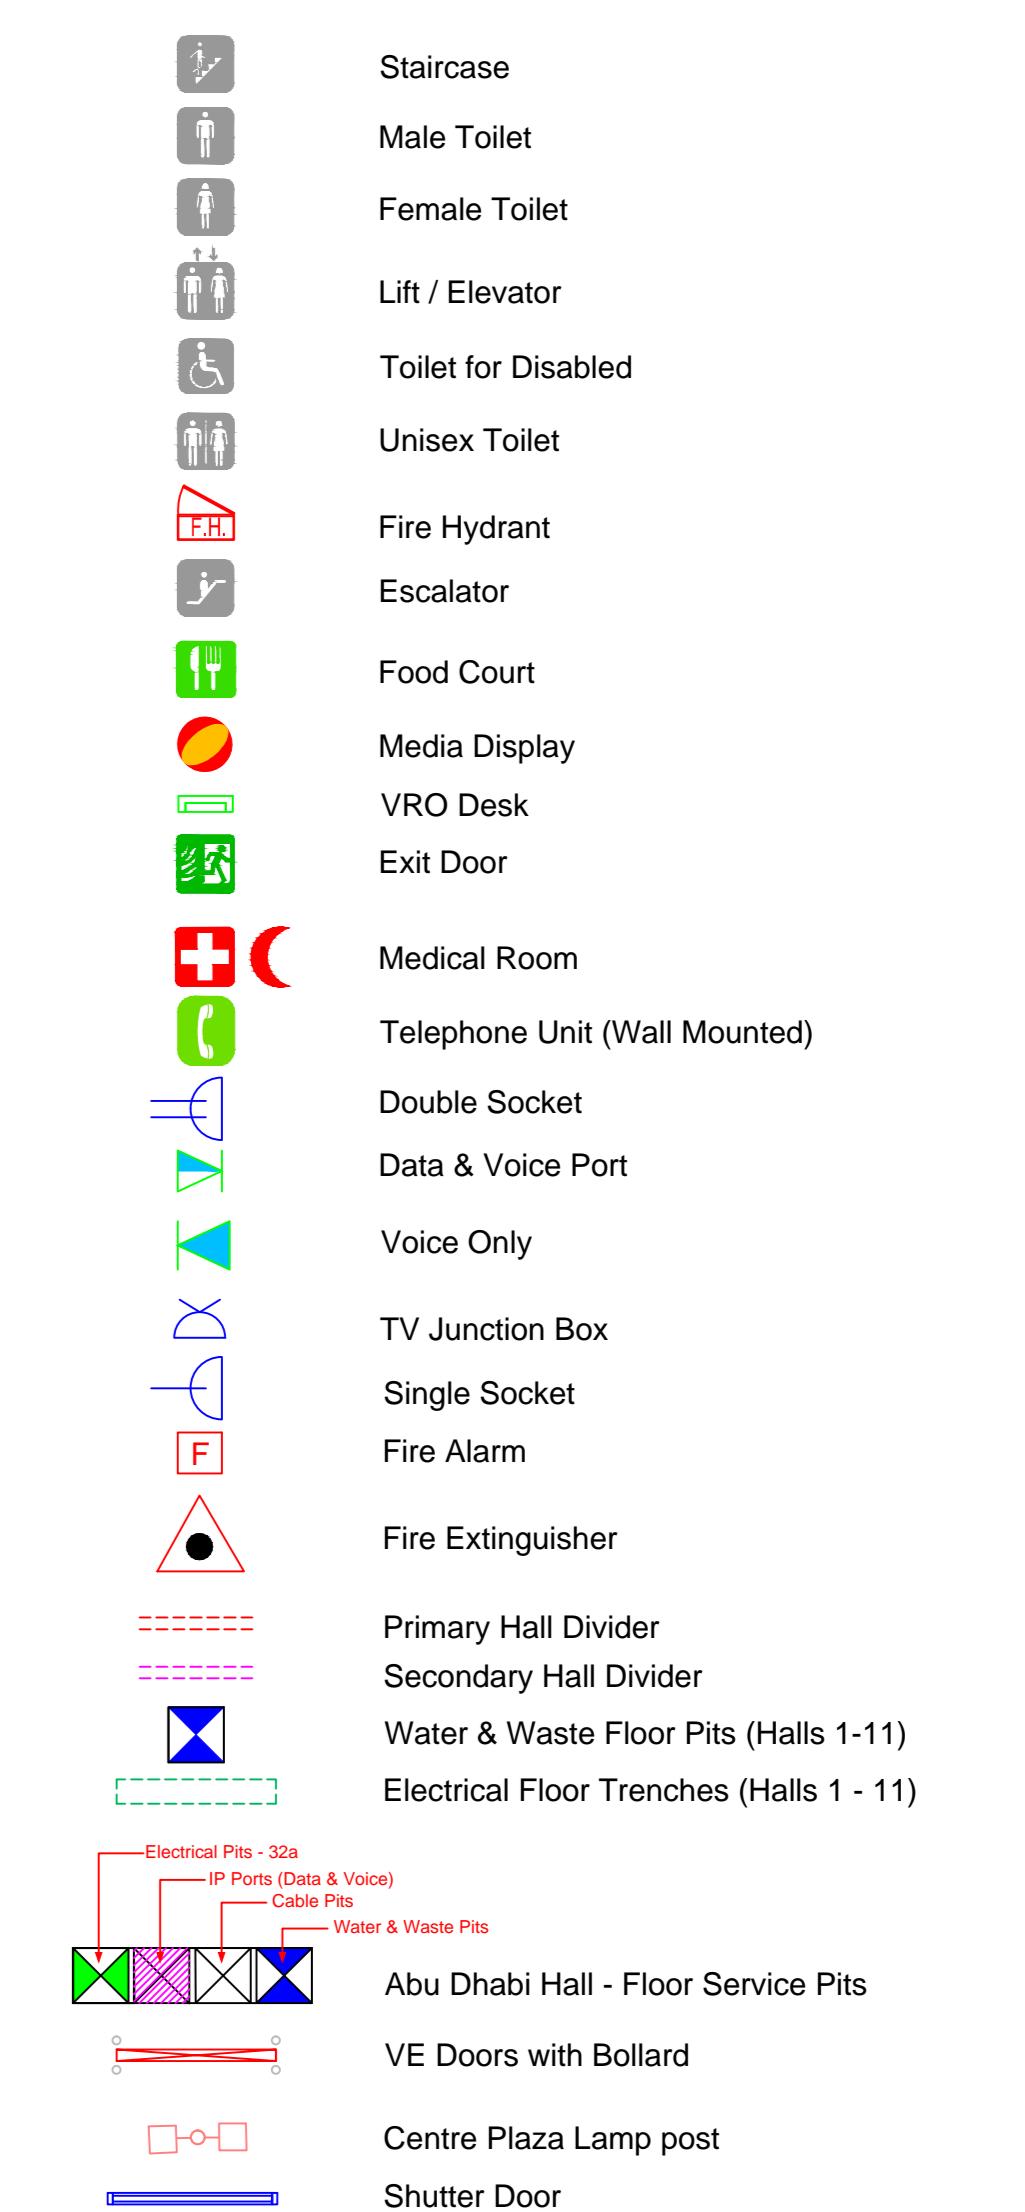

© COPYRIGHT NOTICE
 This drawing is provided in electronic format (.dwg file) for "information purposes" only without any liability on the part of ADNEC. The file, and its contents, remain the property of ADNEC, and shall not be reproduced or re-issued to any third party without express written authorisation from ADNEC.
 The drawing is for reference only and may be subject to change without notice. Updates to this drawing may occur at undefined intervals and shall be notified at the sole discretion of ADNEC. Users are responsible for ensuring that critical dimensions and features are independently verified prior to commencement of any works.

DRAWING TITLE: ADNEC
AS BUILT - GROUND FLOOR GENERAL ARRANGEMENT


SCALE: 1:125 @ A0 DRAWING NO. ADNEC-VGF01-GA

DATE: 16-01-12


APPROVED BY: Adrian Finn

DRAWN BY: Chris Lopez

KEY PLAN: HALL 5

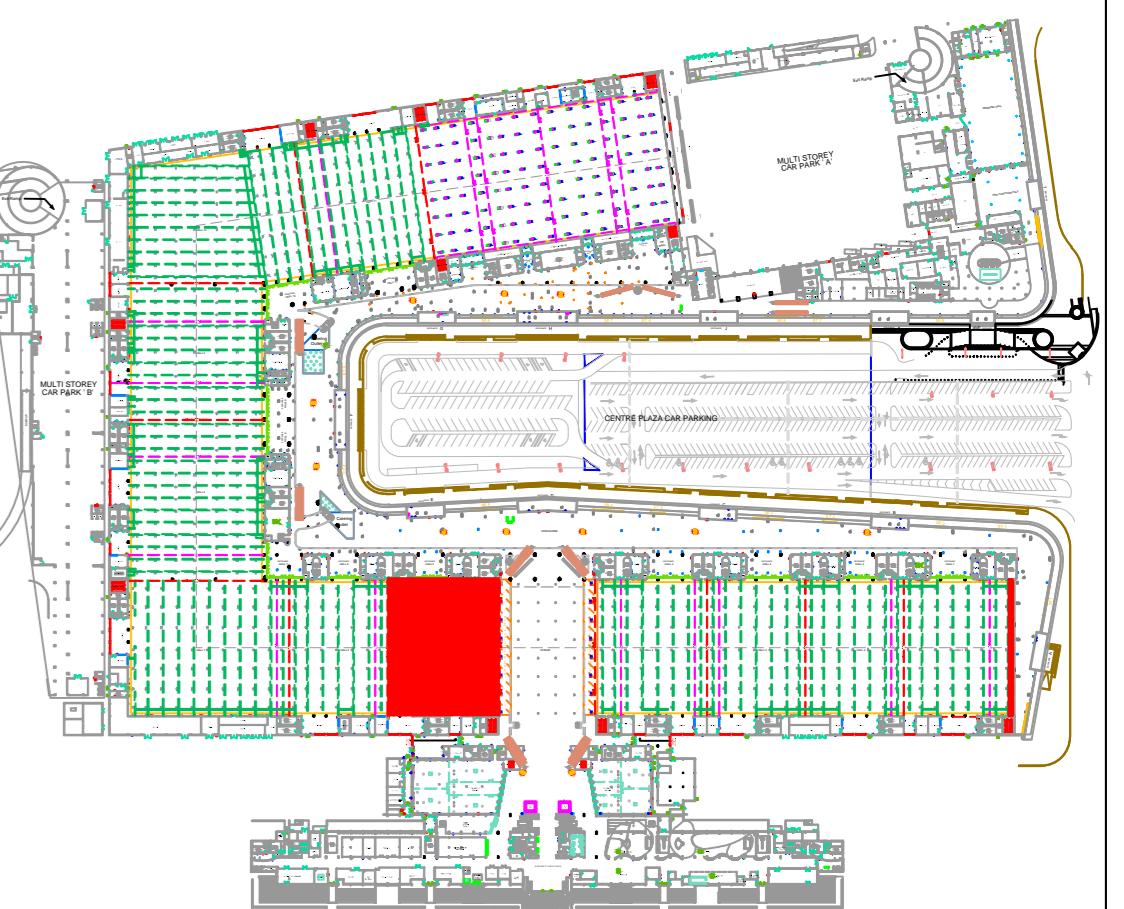

REV. #	REVISION	DATE	REVISED BY
1	AS PER SITE SURVEY	4/25/2011	Chris
2	ALOFT ENTRANCE AMENDED, H12 FLOOR TRENCH & CENTRE PLAZA PARKING	05/01/2011	Chris

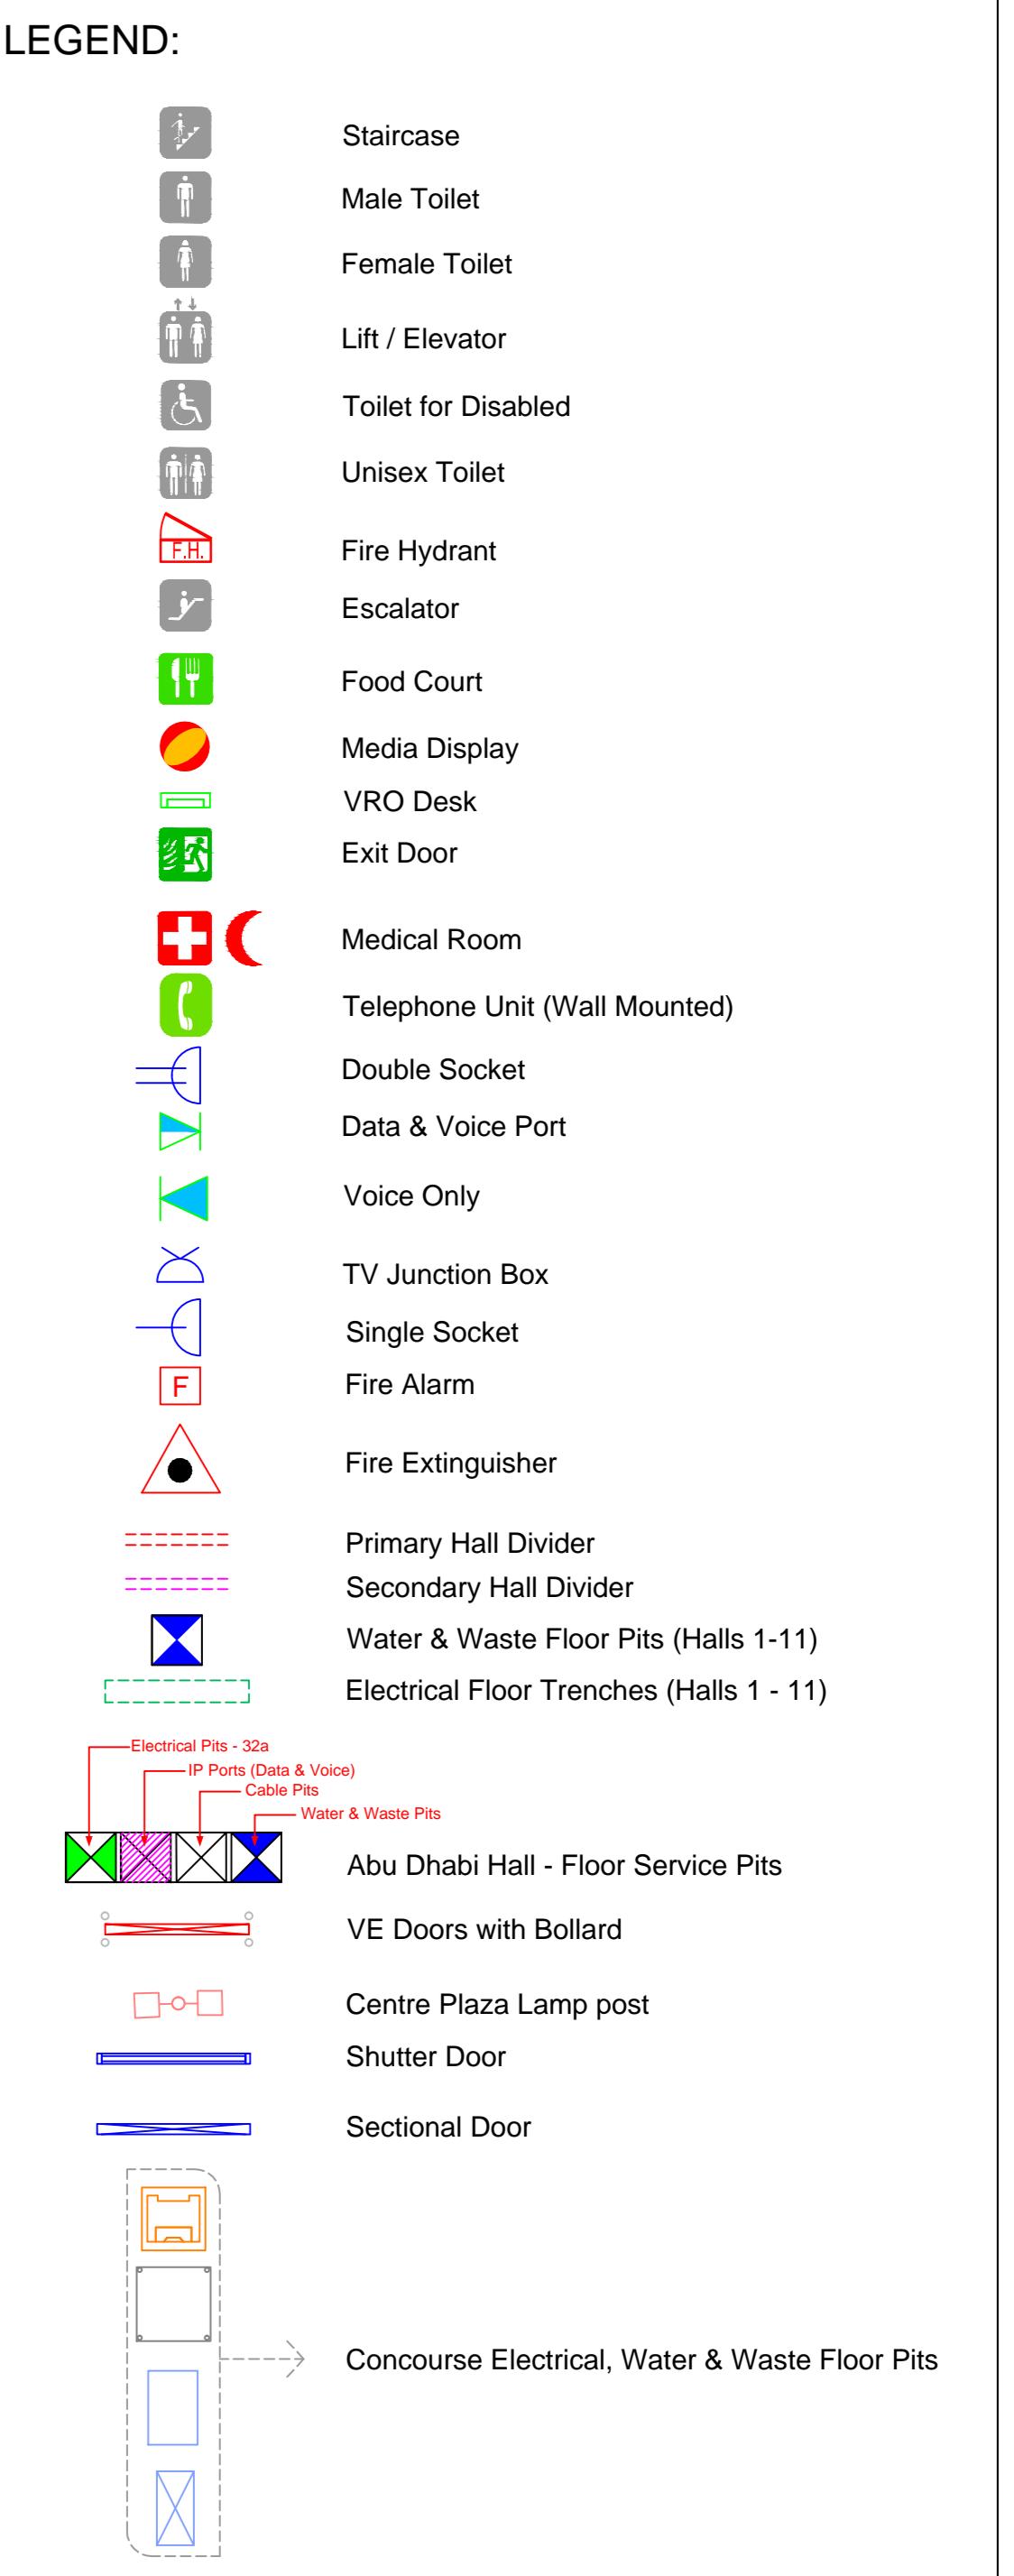

© COPYRIGHT NOTICE
This drawing is provided in electronic format (.dwg file) for "information purposes" only without any liability on the part of ADNEC. The file, and its contents, remain the property of ADNEC, and shall not be reproduced or re-issued to any third party without express written authorisation from ADNEC.
The drawing is for reference only and may be subject to change without notice. Updates to this drawing may occur at undefined intervals and shall be notified at the sole discretion of ADNEC. Users are responsible for ensuring that critical dimensions and features are independently verified prior to commencement of any works.

DRAWING TITLE: **ADNEC AS BUILT - GROUND FLOOR GENERAL ARRANGEMENT**


SCALE: 1:125 @ A0 DRAWING NO. ADNEC-VGF01-GA

DATE: 16-01-12


APPROVED BY: Adrian Finn

DRAWN BY: Chris Lopez










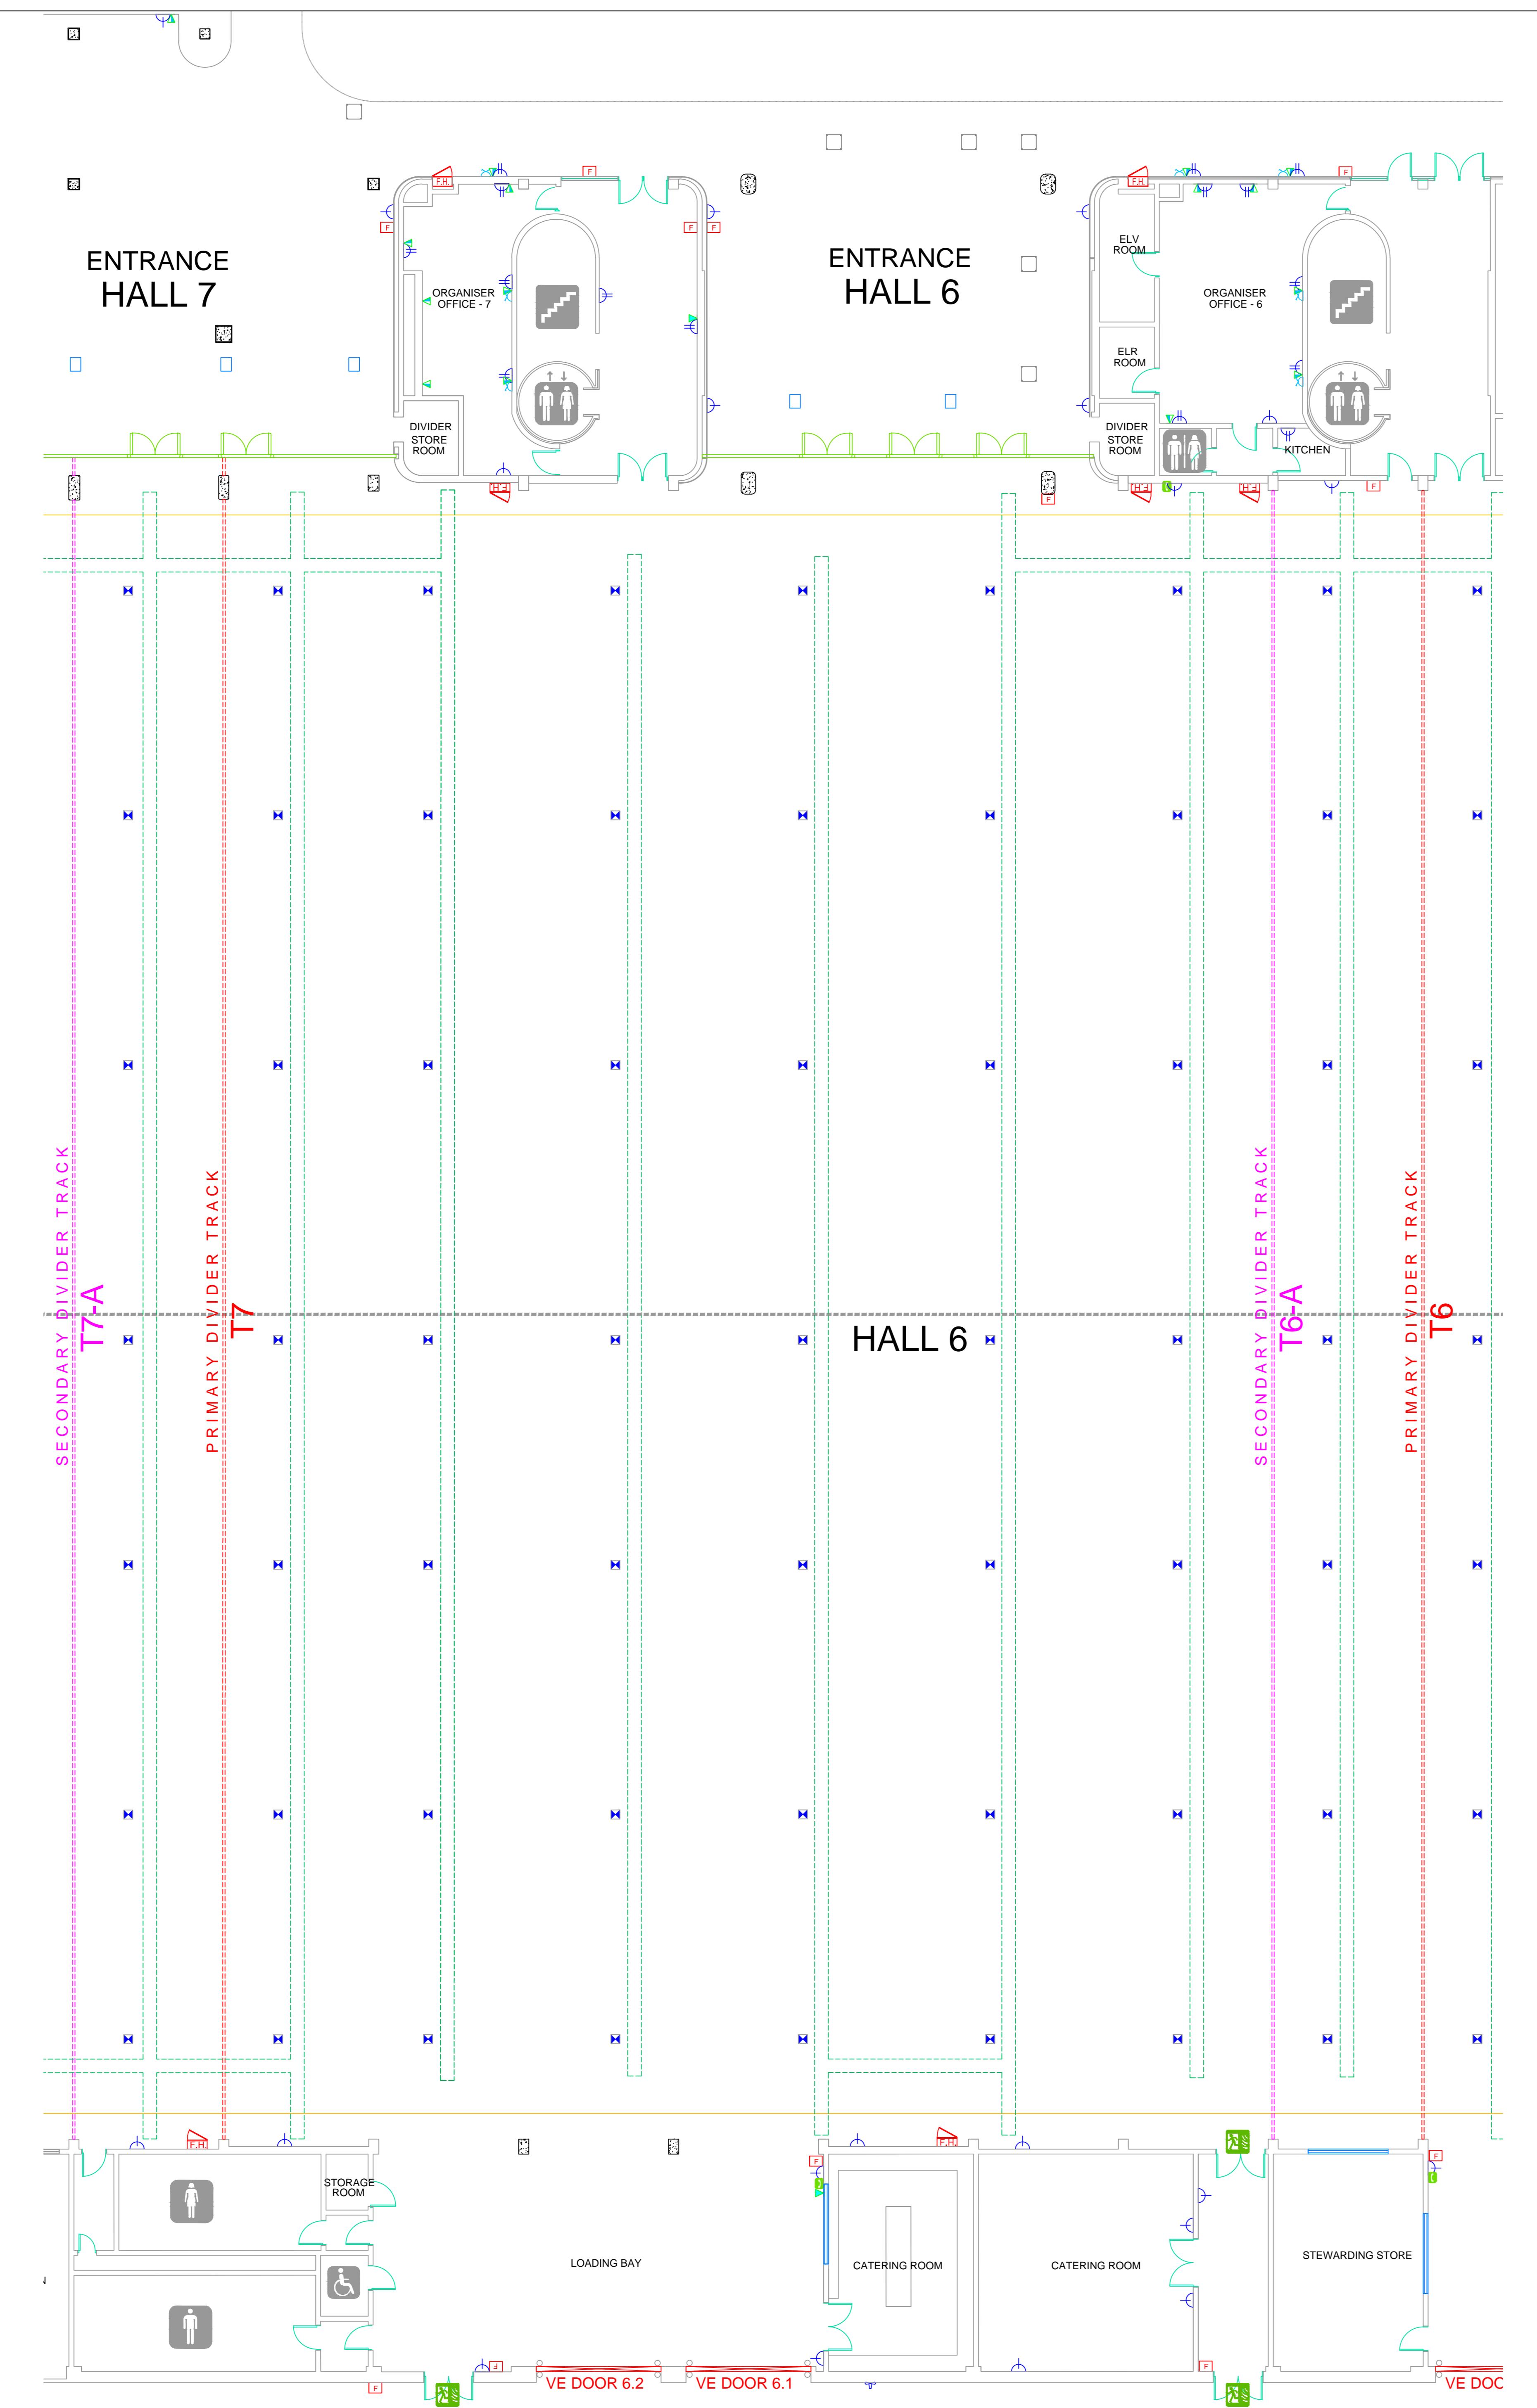


KEY PLAN: HALL 6

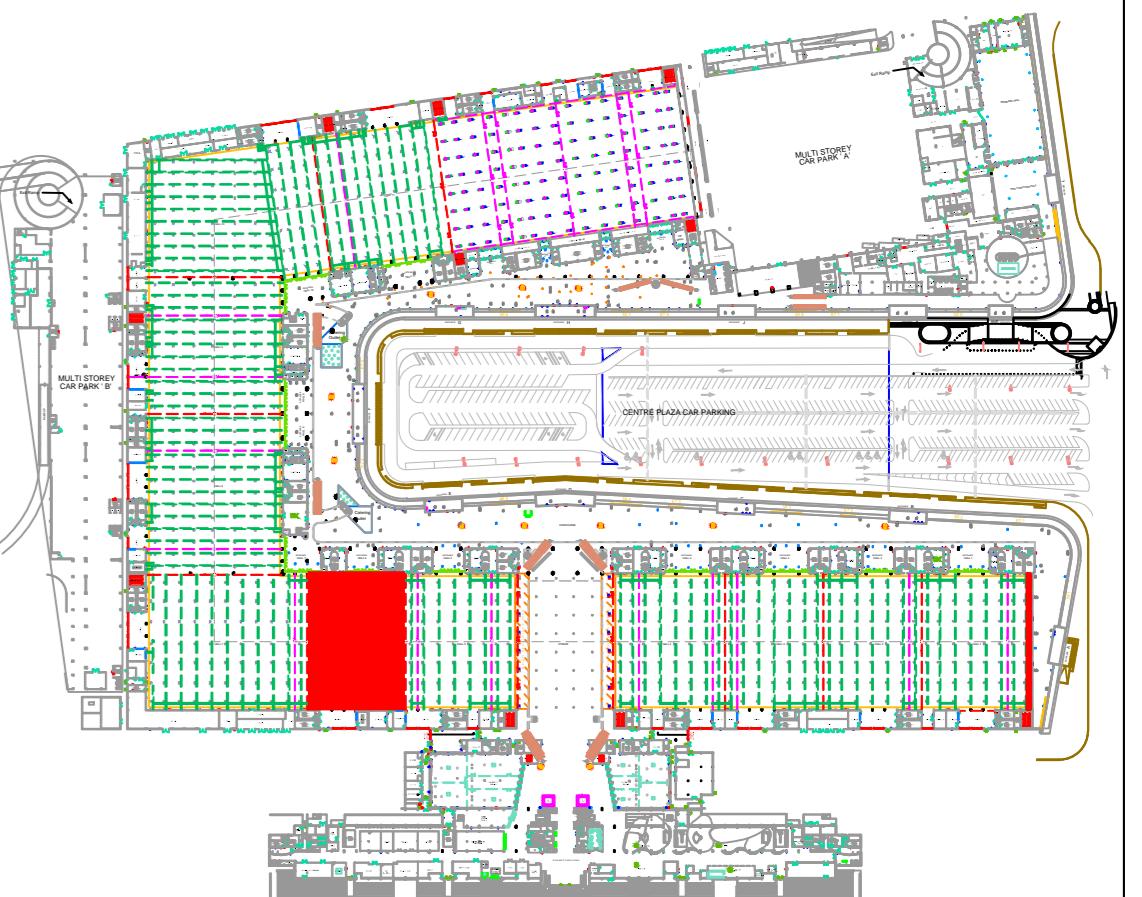

REV. #	REVISION	DATE	REVISED BY
1	AS PER SITE SURVEY	4/25/2011	Chris
2	ALOFT ENTRANCE AMMENDED, H12 FLOOR TRENCH & CENTRE PLAZA PARKING	05/01/2011	Chris

LEGEND:

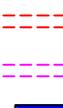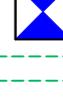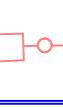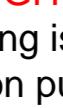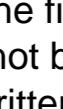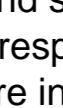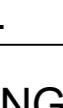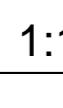	Staircase
	Male Toilet
	Female Toilet
	Lift / Elevator
	Toilet for Disabled
	Unisex Toilet
	Fire Hydrant
	Escalator
	Food Court
	Media Display
	VRO Desk
	Exit Door
	Medical Room
	Telephone Unit (Wall Mounted)
	Double Socket
	Data & Voice Port
	Voice Only
	TV Junction Box
	Single Socket
	Fire Alarm
	Fire Extinguisher
	Primary Hall Divider
	Secondary Hall Divider
	Water & Waste Floor Pits (Halls 1-11)
	Electrical Floor Trenches (Halls 1 - 11)
	Abu Dhabi Hall - Floor Service Pits
	VE Doors with Bollard
	Centre Plaza Lamp post
	Shutter Door
	Sectional Door
	Concourse Electrical, Water & Waste Floor Pits

© COPYRIGHT NOTICE

This drawing is provided in electronic format (.dwg file) for "information purposes" only without any liability on the part of ADNEC. The file, and its contents, remain the property of ADNEC, and shall not be reproduced or re-issued to any third party without express written authorisation from ADNEC.

The drawing is for reference only and may be subject to change without notice. Updates to this drawing may occur at undefined intervals and shall be notified at the sole discretion of ADNEC. Users are responsible for ensuring that critical dimensions and features are independently verified prior to commencement of any works.

DRAWING TITLE: A D N E C
AS BUILT - GROUND FLOOR
GENERAL ARRANGEMENT

SCALE:	DRAWING NO.
1:125@A0	ADNEC-VGF01-GA

DATE:	16-01-12
-------	----------

APPROVED BY:	Adrian Finn
--------------	-------------

DRAWN BY:	Chris Lopez
-----------	-------------

 
A decorative graphic element in the bottom right corner of the slide, featuring three blue bars of different lengths and orientations.

 
ADNFC

ADNEC


شركة أبوظبي الوطنية للمعارض
Abu Dhabi National Exhibitions Company

KEY PLAN: HALL 7






KEY PLAN: HALL 9

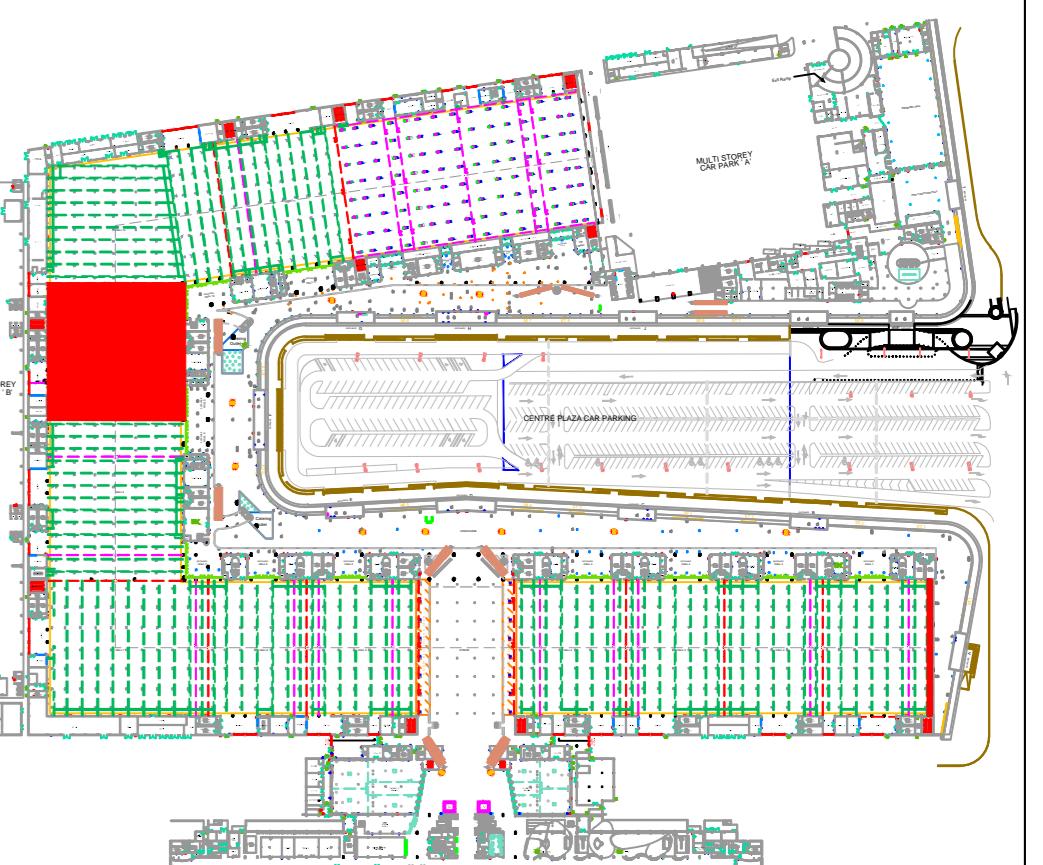

REV. #	REVISION	DATE	REVISED BY
1	AS PER SITE SURVEY	4/25/2011	Chris
2	ALOFT ENTRANCE AMENDED, H12 FLOOR TRENCH & CENTRE PLAZA PARKING	05/01/2011	Chris

LEGEND:

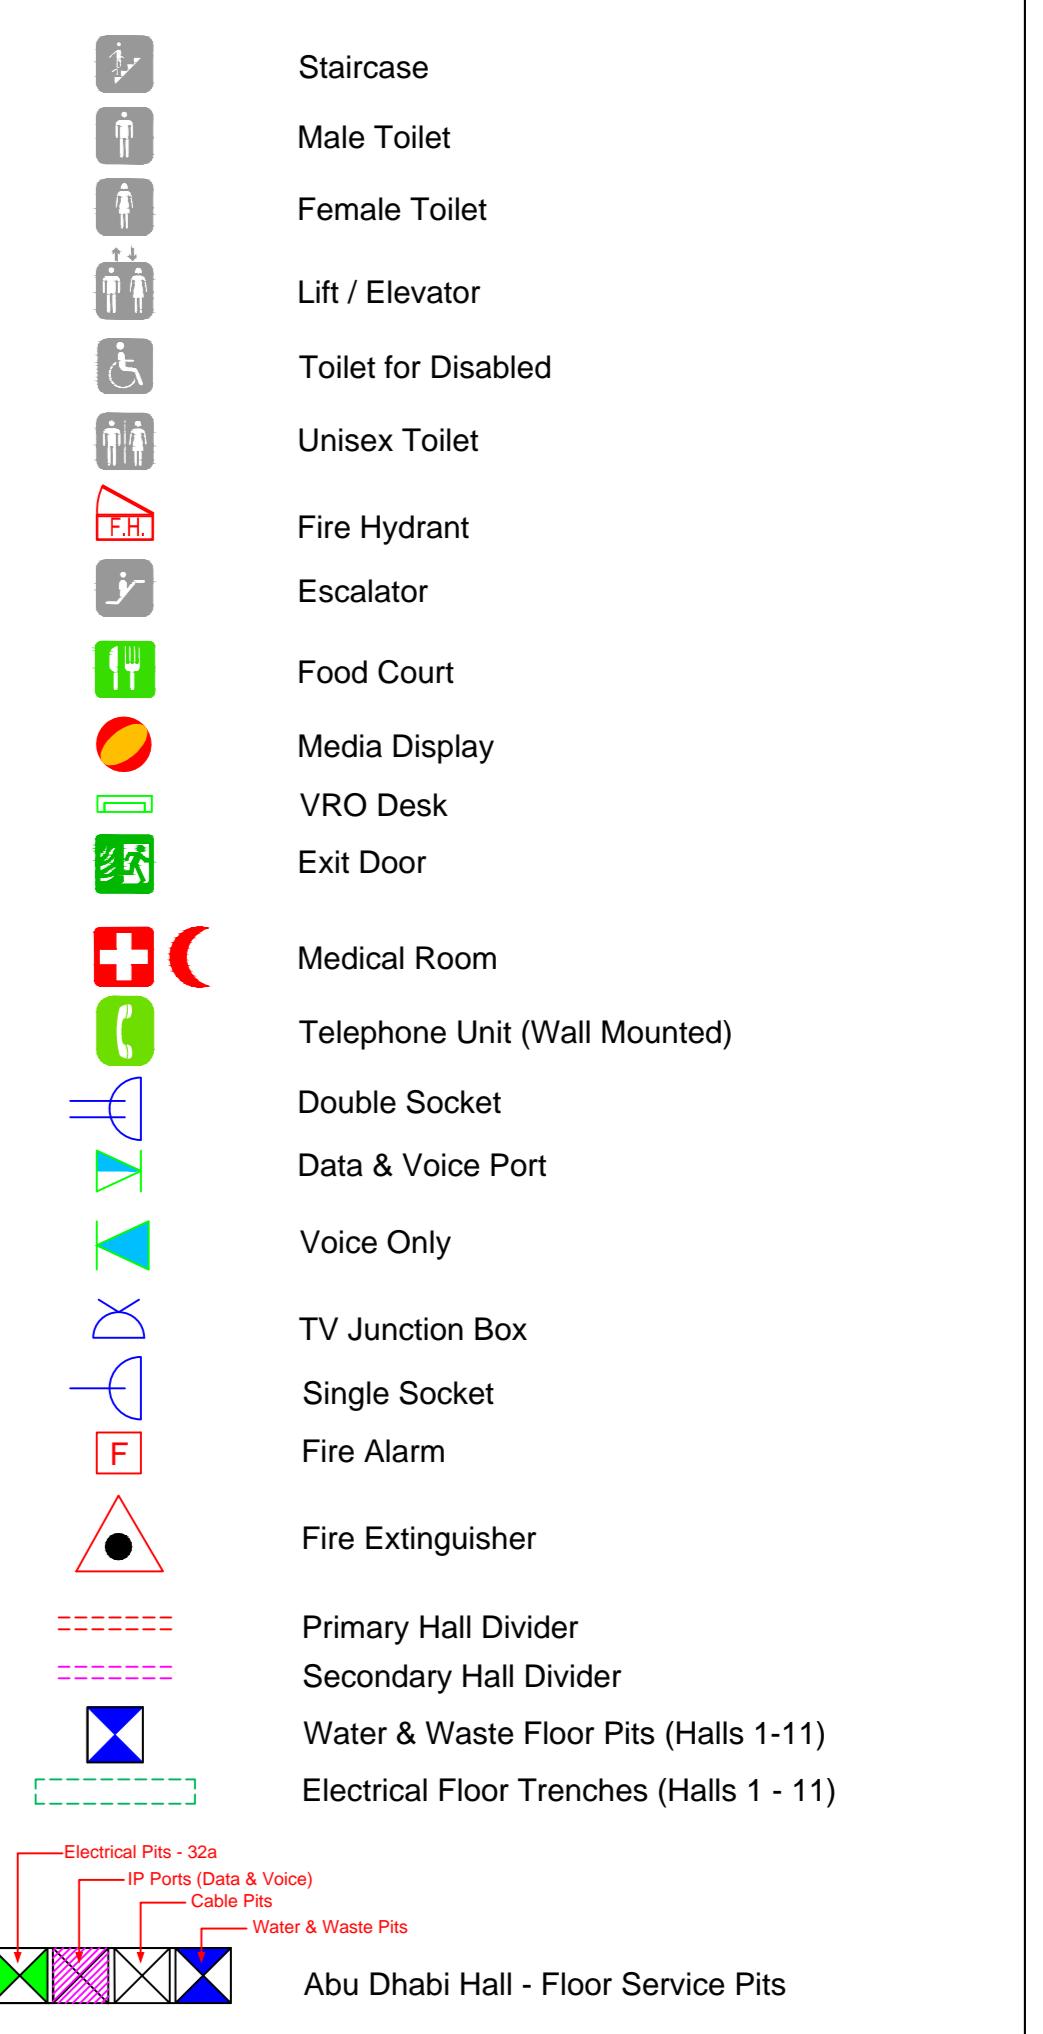

© COPYRIGHT NOTICE
This drawing is provided in electronic format (.dwg file) for "information purposes" only without any liability on the part of ADNEC. The file, and its contents, remain the property of ADNEC, and shall not be reproduced or re-issued to any third party without express written authorisation from ADNEC.
The drawing is for reference only and may be subject to change without notice. Updates to this drawing may occur at undefined intervals and shall be notified at the sole discretion of ADNEC. Users are responsible for ensuring that critical dimensions and features are independently verified prior to commencement of any works.

 
DRAWING TITLE: **ADNEC AS BUILT - GROUND FLOOR GENERAL ARRANGEMENT**

 
SCALE: 1:100 @ A0 DRAWING NO. ADNEC-VGF01-GA

DATE: 16-01-12


APPROVED BY: Adrian Finn

DRAWN BY: Chris Lopez






KEY PLAN: HALL 11

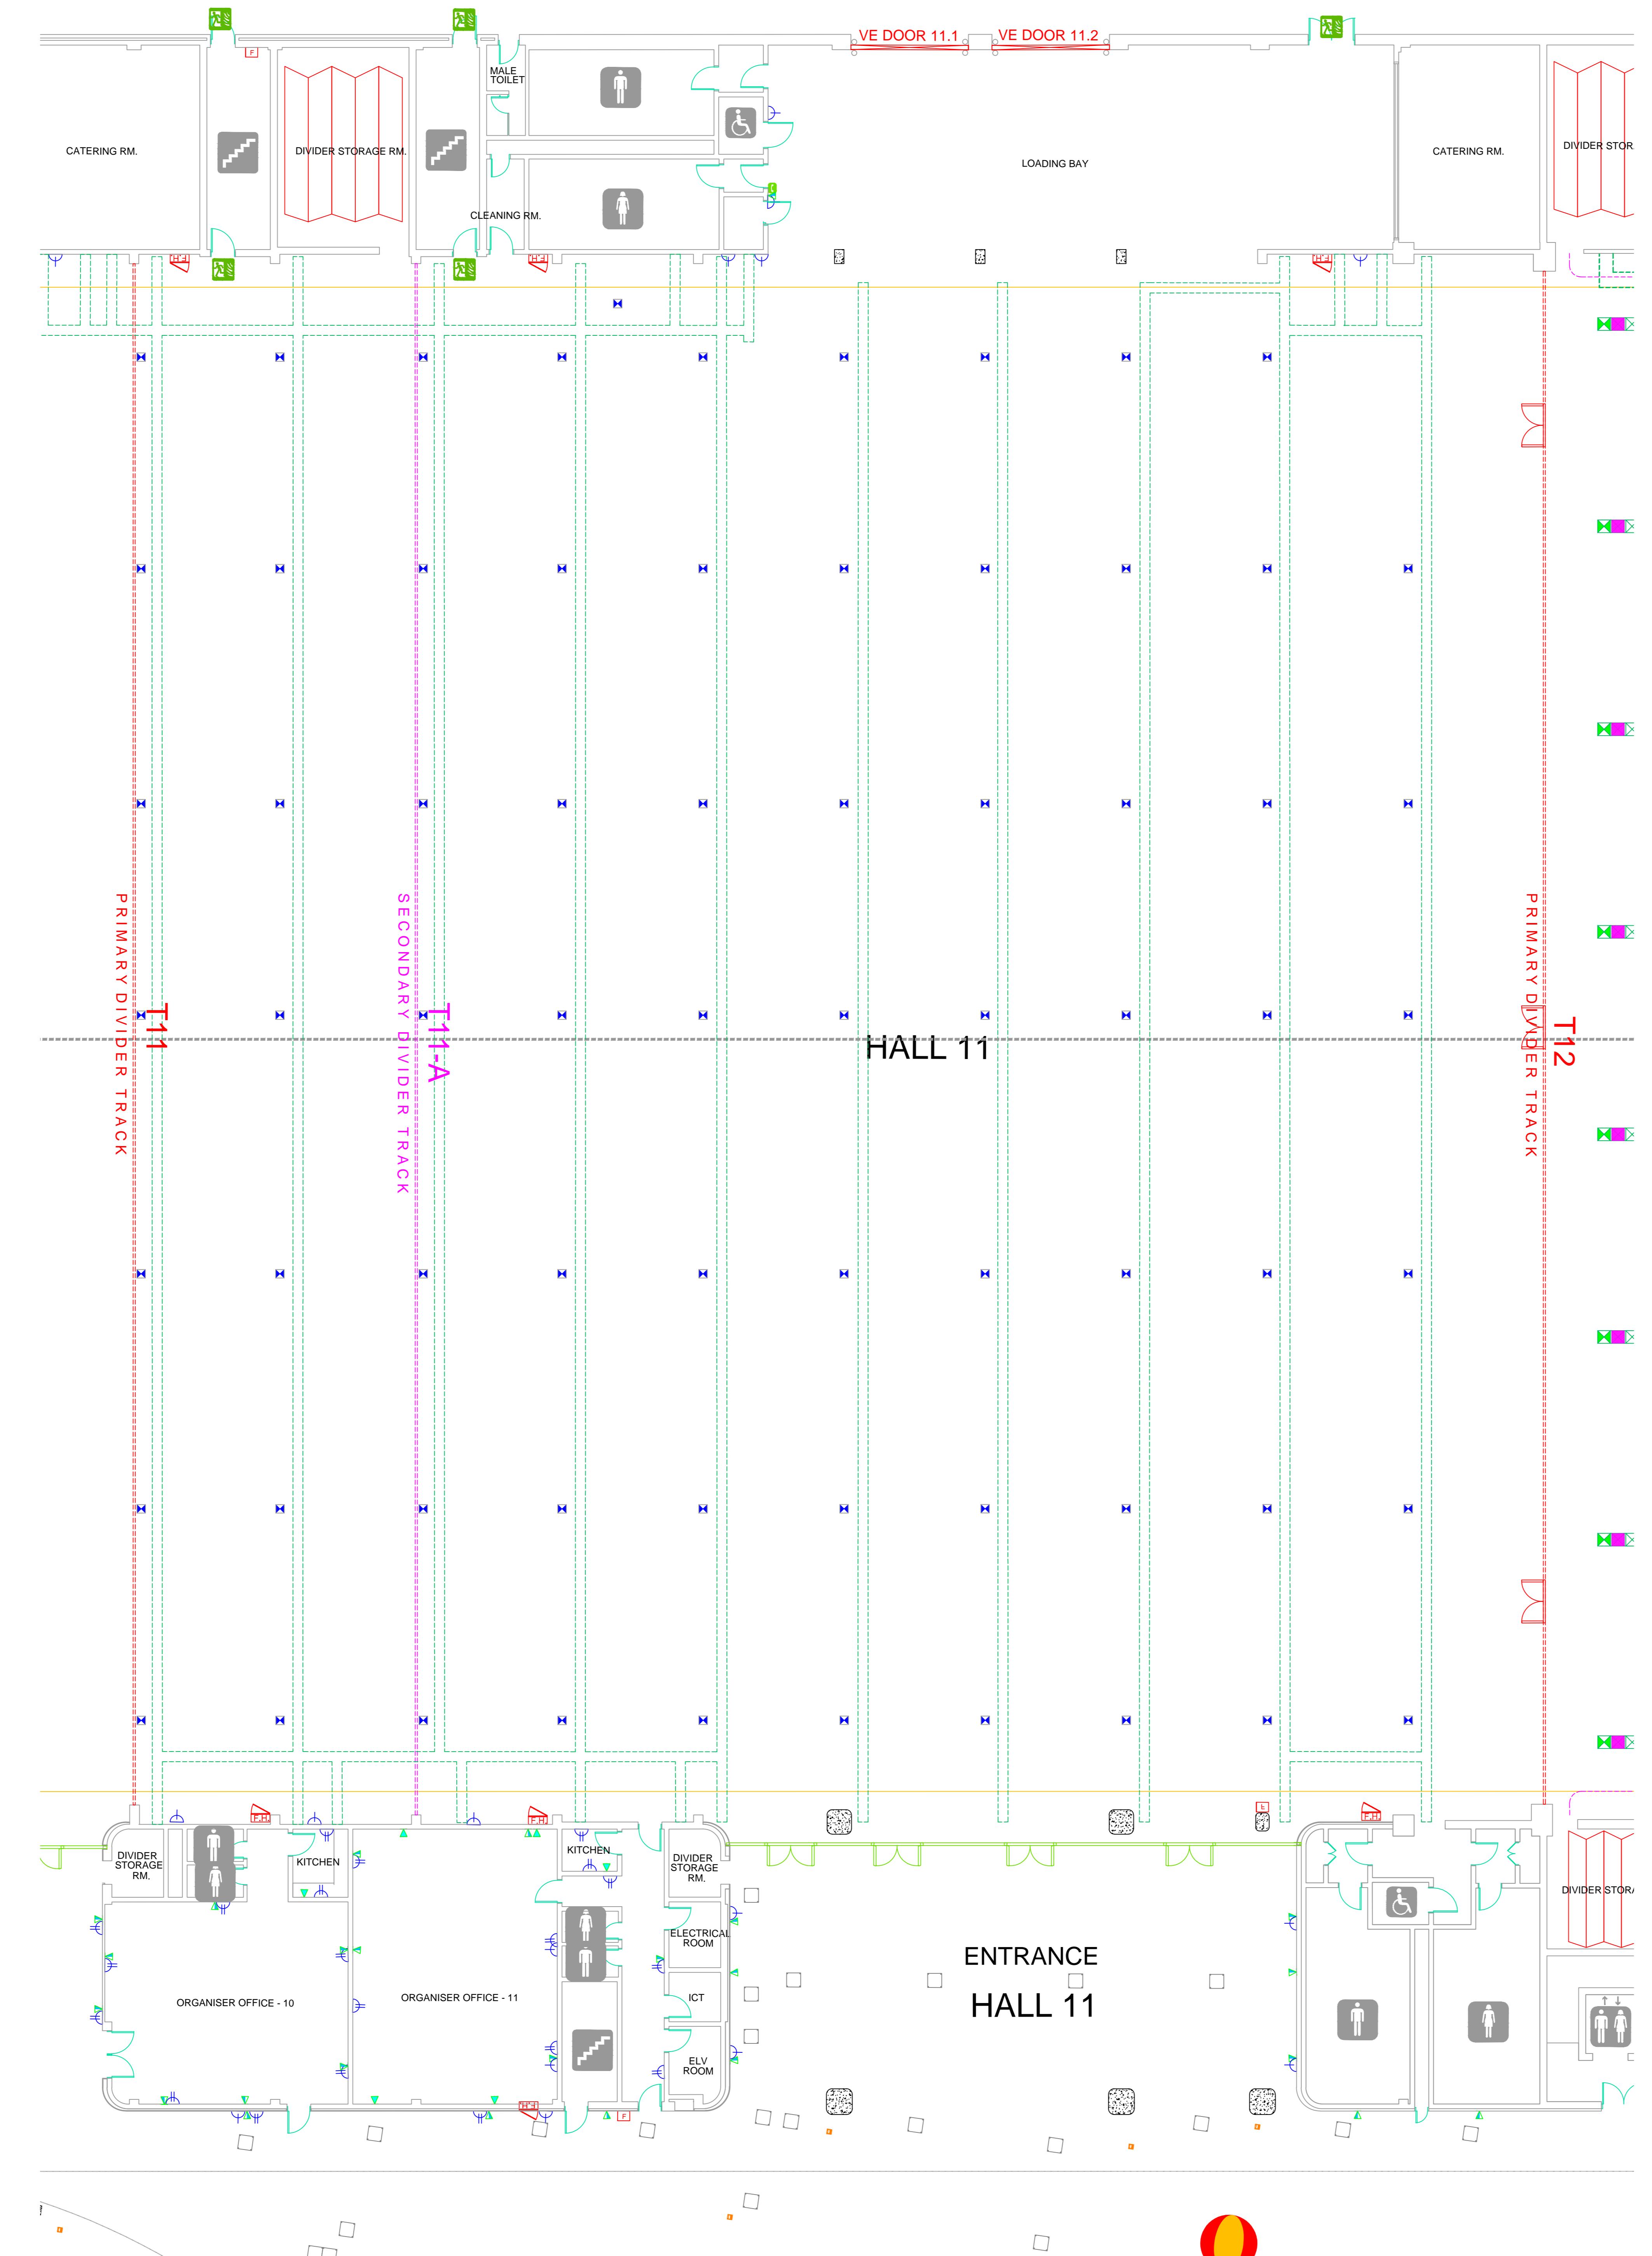

REV. #	REVISION	DATE	REVISED BY
1	AS PER SITE SURVEY	4/25/2011	Chris
2	ALOFT ENTRANCE AMENDED, H12 FLOOR TRENCH & CENTRE PLAZA PARKING	05/01/2011	Chris

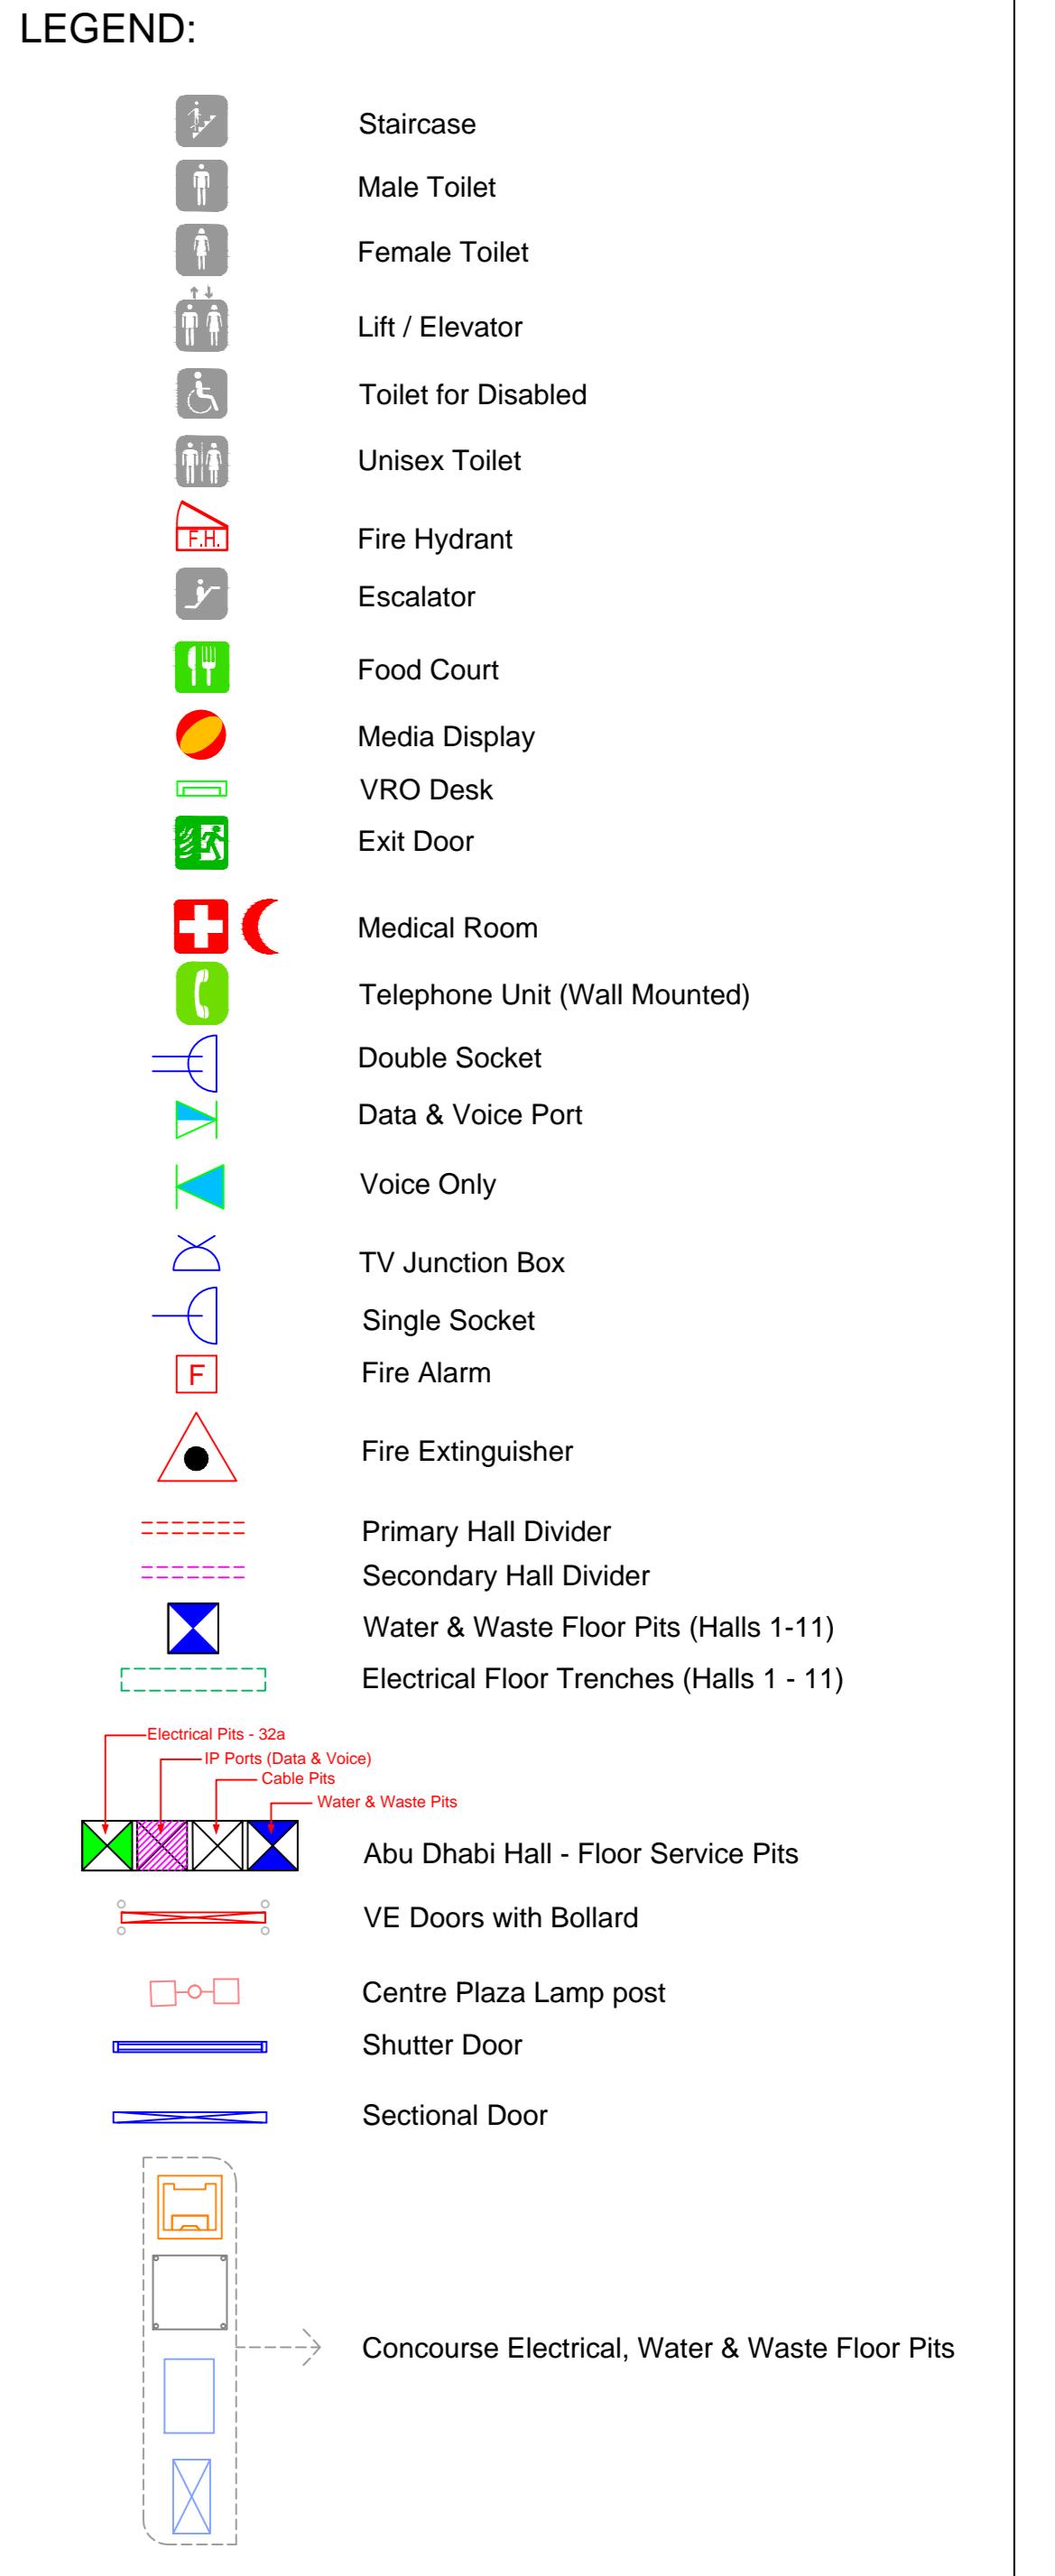


© COPYRIGHT NOTICE

This drawing is provided in electronic format (.dwg file) for "information purposes" only without any liability on the part of ADNEC. The file, and its contents, remain the property of ADNEC, and shall not be reproduced or re-issued to any third party without express written authorisation from ADNEC.

The drawing is for reference only and may be subject to change without notice. Updates to this drawing may occur at undefined intervals and shall be notified at the sole discretion of ADNEC. Users are responsible for ensuring that critical dimensions and features are independently verified prior to commencement of any works.

SCALE:	DRAWING NO.
1:125 @ A0	ADNEC-VGF01-GA
DATE:	16-01-12
APPROVED BY:	Adrian Finn
DRAWN BY:	Chris Lopez

KEY PLAN: ICC ABU DHABI

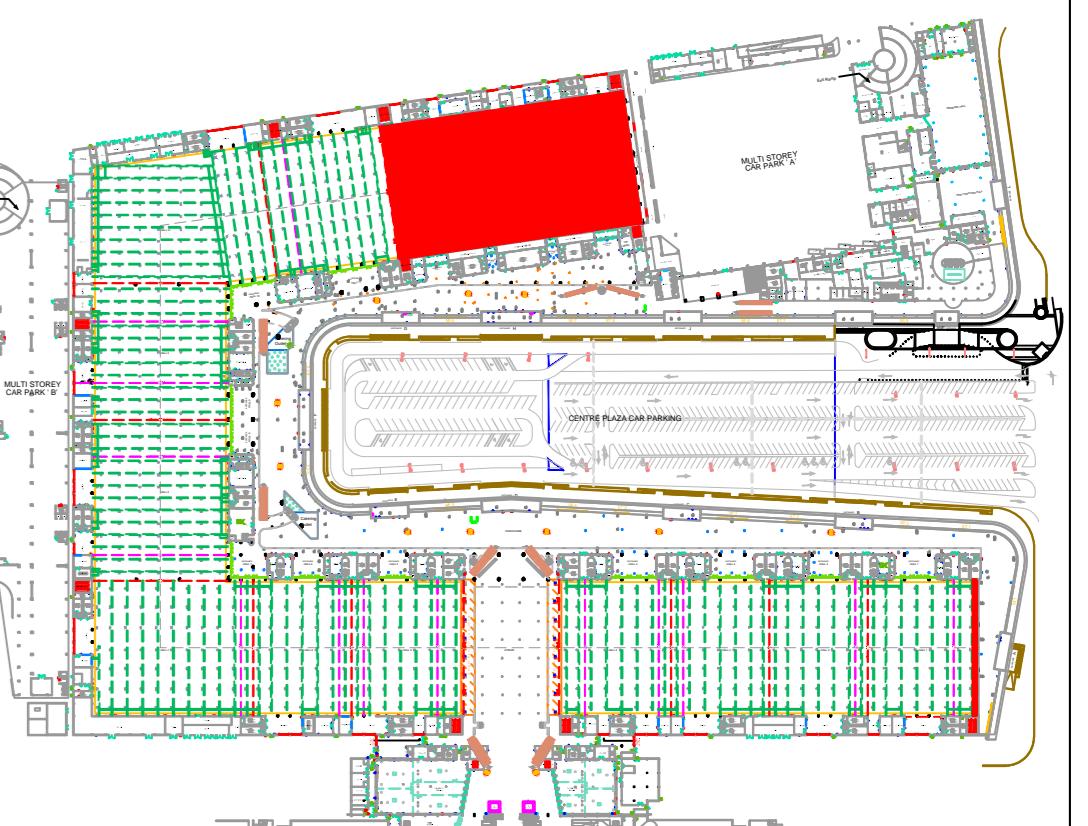

REV. #	REVISION	DATE	REVISED BY
1	AS PER SITE SURVEY	4/25/2011	Chris
2	ALOFT ENTRANCE AMENDED, H12 FLOOR TRENCH & CENTRE PLAZA PARKING	05/01/2011	Chris

LEGEND:



© COPYRIGHT NOTICE
 This drawing is provided in electronic format (.dwg file) for "information purposes" only without any liability on the part of ADNEC. The file, and its contents, remain the property of ADNEC, and shall not be reproduced or re-issued to any third party without express written authorisation from ADNEC.
 The drawing is for reference only and may be subject to change without notice. Updates to this drawing may occur at undefined intervals and shall be notified at the sole discretion of ADNEC. Users are responsible for ensuring that critical dimensions and features are independently verified prior to commencement of any works.

DRAWING TITLE: ADNEC AS BUILT - GROUND FLOOR GENERAL ARRANGEMENT

SCALE: 1:150 @ A0 **DRAWING NO.:** ADNEC-VGF01-GA

DATE: 16-01-12

APPROVED BY: Adrian Finn

DRAWN BY: Chris Lopez

